


Index File No. E-5  
 T 5 S. R. 30 E.  
 Merid. Willamette

**CORNER RECORD (SEARCH)**  
 (Ref. FSM 7151.4)

Tract or Survey No. \_\_\_\_\_  
 Cor. No. \_\_\_\_\_

R.D. Ukiah County Umatilla  
 N.F. Umatilla State Oregon

**CORNER DIAGRAM**

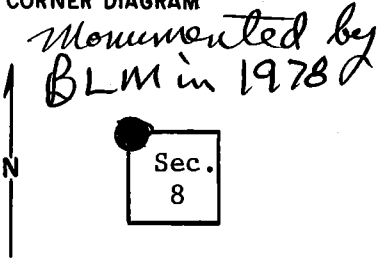

**DESCRIBE CORNER MONUMENT FOUND**

Basalt stone, approx. same as GLO notes; 10" (pointed end up) above ground; good condition. Appears to be notched on south and east edges. Sets in circle of smaller stones. (There is an old survey stake nearby.)

**DESCRIBE BEARING TREES OR OTHER OFFICIAL ACCESSORIES FOUND**

None. All B.T.'s were small pine (probably lodgepole). All are gone. Some evidence of rotted root system in SW and NE B.T. locations. (SE and NW B.T. locations covered with snow drifts.)

**PHOTO IDENTIFICATION DATA**

Photo No. \_\_\_\_\_  
 Filed At. \_\_\_\_\_  
 Object Ident. \_\_\_\_\_  
 Ident. By \_\_\_\_\_  
*Signature*

**DESCRIBE CORNER LOCATION RELATIVE TO NEAR-BY FEATURES, ALSO HOW TO REACH CORNER**

Assumed corner stone sets approx. 30 ft. north of small stream (fits original GLO notes) and approx. 300 ft. up this small stream from Five Mile Creek (fits map). It is located within a lodgepole thinning area, amid a stand of mature western larch. To reach, proceed to end of logging spur road (pit-run gravelled) NW of corner (in Section 6) (cont. in block 12)

**PLANE COORDINATE POSITION DATA**

State \_\_\_\_\_ Zone \_\_\_\_\_  
 X \_\_\_\_\_  
 Y \_\_\_\_\_  
 Estab. By \_\_\_\_\_  
*Agency*

Signature	Title	Division	Headquarters	Date	7100-52-(3/68)
T, Hollamon	Eng, Tech.		S, O,	5/2/74	

## CORNER RECORD (PERPETUATION)

MONUMENT : DESCRIBE NEW MONUMENT SET, OR WORK DONE TO PRESERVE EXISTING MONUMENT

ACCESSORIES : DESCRIBE NEW BT'S WITNESS OBJECTS ETC. ESTABLISHED, OR WORK DONE TO PRESERVE EXISTING EVIDENCE

I placed a location poster on a 7" lodgepole pine approx. 6 ft. south of stone. (This tree has some blazes and a small X chopped on it (apparently done since original survey)). I also placed a location poster on a 10" Douglas fir at end of spur road (approx. on East-west section line) about 900 feet west of corner.

I also tied red and white striped ribbon on the stone, the stake and the nearby L.P. pine on which I placed the location poster.

Work Done By \_\_\_\_\_ Title \_\_\_\_\_ Date \_\_\_\_\_ State Registration No. or Agency \_\_\_\_\_

Certified Cor. Record Prepared ? Yes No Filed At: \_\_\_\_\_ Date \_\_\_\_\_

### REMARKS

(Cont. from Block 4)  
(See Matlock Prairie 7.5 minute quadrangle map.) Walk SE to bottom of small drainage, continue down drainage to corner location previously described.

Index File No. T. R. M. Tract or Surv. No. Cor. 12 13