

(PA)

Index
File No. G-13
T 5S R. 30E


CORNER RECORD (SEARCH)

(Ref. FSM 7151.4)

Tract or Survey No. _____ Cor. No. G-13

Merid. Willamette N.F. Umatilla State Oregon

CORNER DIAGRAM

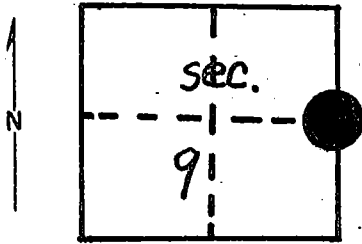

DESCRIBE CORNER MONUMENT FOUND

None found

Monumented by BLM in 1978

DESCRIBE BEARING TREES OR OTHER OFFICIAL ACCESSORIES FOUND

Chopped out one bearing tree, the only one remaining. scribing faces NW Put up corner tag and bearing tree marker

PHOTO IDENTIFICATION DATA

Photo No. _____
Filed At. _____
Object Ident. _____
Ident. By _____
Signature

PLANE COORDINATE POSITION DATA

State _____ Zone _____
X _____
Y _____
Estab. By _____
Agency

DESCRIBE CORNER LOCATION RELATIVE TO NEAR-BY FEATURES, ALSO HOW TO REACH CORNER

Signature A.W. Hamill Title Forester Division USFS Headquarters Ukiah Date 9/11/64 7100-52 (3/68)