

USDA-FOREST SERVICE

Index File No. H-6

CORNER RECORD (SEARCH)

(Ref. FSM 7151.4)

Tract or Survey No. _____ Cor. No. _____

12


T 55 R. 30E

R.D. Ukiah County Umatilla

Merid. Willamette

N.F. Umatilla State Ore.

CORNER DIAGRAM

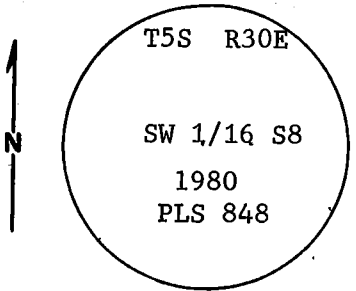

DESCRIBE CORNER MONUMENT FOUND

Corner not previously established.

DESCRIBE BEARING TREES OR OTHER OFFICIAL ACCESSORIES FOUND

N.A.

PHOTO IDENTIFICATION DATA

Photo No. _____

Filed At. _____

Object Ident. _____

Ident. By _____

Signature

PLANE COORDINATE POSITION DATA

State _____ Zone _____

X _____

Y _____

Estab. By _____

Agency

Signature

Title

Division

Headquarters

Date

7100-52-(3/68)

CORNER RECORD (PERPETUATION)

MONUMENT: DESCRIBE NEW MONUMENT SET, OR WORK DONE TO PRESERVE EXISTING MONUMENT

Set 3"x30" galv iron pipe with 3" brass cap, 25" in the ground. Stamped brass cap as shown in the diagram.

9

ACCESSORIES : DESCRIBE NEW BT'S WITNESS OBJECTS ETC. ESTABLISHED, OR WORK DONE TO PRESERVE EXISTING EVIDENCE

From which:

A fir 16" dia bears S 47 45' E 48.7 ft. scribed SW 1/16 S8 BT.

A fir 8" dia bears S 87 30' W 11.2ft. " " " " "

Nailed brass washers stamped PLS 848 & bearing tree signs to all bearing trees.

Painted red band around all bearing trees.

Set steel posts 5'N & 5'E - warning & bdry signs.

Bearing Solar Grid.

10

Work Done By D. M. Ferguson Title Surveyor Date 9-3-80 State Registration No. PLS 848 or Agency

Certified Cor. Record Prepared Yes No Filed At: _____ Date _____

11

REGISTERED
PROFESSIONAL
LAND SURVEYOR

REMARKS

Witness to above corner.

L. Wyllie

OREGON
JULY 12, 1968
DOUGLAS M. FERGUSON
848

12

Index File No. _____ T. _____ R. _____ M. _____ Tract or Surv. No. _____ Cor. _____ U.S. G.P.O. 1977-725-576/586

13