

USDA-FOREST SERVICE

Index File No. H-7

CORNER RECORD (SEARCH)

(Ref. FSM 7151.4)

T 55 R. 30E


R.D. Ukiah County

Tract or Survey No. _____ Cor. No. _____

Merid. Willamette

N.F. Umatilla State Ore.

CORNER DIAGRAM

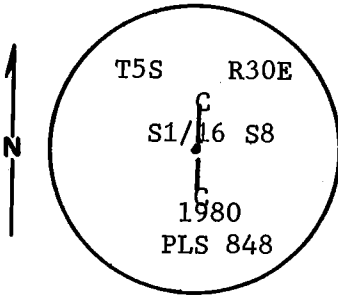

DESCRIBE CORNER MONUMENT FOUND

Corner not previously established.

DESCRIBE BEARING TREES OR OTHER OFFICIAL ACCESSORIES FOUND

N.A.

PHOTO IDENTIFICATION DATA

Photo No. _____

Filed At. _____

Object Ident. _____

Ident. By _____

Signature

PLANE COORDINATE POSITION DATA

State _____ Zone _____

X _____

Y _____

Estab. By _____

Agency

Signature

Title

Division

Headquarters

Date

7100-52-(3/68)

CORNER RECORD (PERPETUATION)

MONUMENT: DESCRIBE NEW MONUMENT SET, OR WORK DONE TO PRESERVE EXISTING MONUMENT

Set 3"x30" galv iron pipe with 3" brass cap 14" in the ground & stamped brass cap as shown on the diagram. Raised a mound of stone around pipe.

ACCESSORIES : DESCRIBE NEW BT'S WITNESS OBJECTS ETC. ESTABLISHED, OR WORK DONE TO PRESERVE EXISTING EVIDENCE

From which:

A fir 15" dia. bears N 86 E 7.6 ft. scribed C S 1/16 S8 BT.

A pine 10" dia. Bears S 50-45' W 28.4 ft. " " " " "

Set steel posts 5'E & 5'W from corner with bdry. & warning signs attached.

Nailed brass washers stamped PLS 848 & bearing tree signs to each tree, painted red band around each tree.

Bearing-Solar Grid.

Work Done By D. M. Ferguson Title Surveyor Date 9-4-80 State Registration No. PLS 848
or Agency

Certified ~~REGISTERED~~ Yes No Filed At: _____ Date _____

**PROFESSIONAL
LAND SURVEYOR**

REMARKS

Witnesses to above corner.

D. Herburger

L. Wyllie

Douglas M. Ferguson
**OREGON
JULY 12, 1968
DOUGLAS M. FERGUSON
848**

Index File No. T. R. M. Tract or Surv. No. Cor.
U.S. G.P.O. 1977-725-576/586 **13**