

USDA-FOREST SERVICE

Index  
File No. N-21

CORNER RECORD (SEARCH)


(Ref. FSM 7151.4)

Tract or  
Survey No. \_\_\_\_\_ Cor. No. \_\_\_\_\_

T 5S R. 30E R.D. NORTH FORK J.D. County UMATILLA

Merid. WILLAMETTE N.F. UMATILLA State OREGON

CORNER DIAGRAM

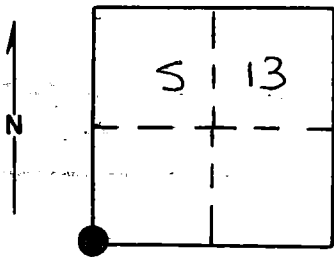

DESCRIBE CORNER MONUMENT FOUND

Found 2½" brass cap monument marked:  
in a mound of stone.

T5S R30E	
S 14	S 13
S 23	S 24
1973	

DESCRIBE BEARING TREES OR OTHER OFFICIAL ACCESSORIES FOUND

A 14" Douglas Fir N30°E, 123 lks. live and vigorous with scribes visible. A 18" Ponderosa Pine stump N31°E, 46.9 ft. burned with no scribes visible. A 10 inch diameter Douglas Fir S34½°E, 98 lks, live and vigorous with scribes visible. A 30" Ponderosa Pine stump S6°E, 153 lks with blaze evident. A 28" Ponderosa Pine S10°W, 177 lks. live and vigorous with scribes visible. A 35" Ponderosa Pine N21°W, 15 lks. live and vigorous upper face scorched by fire years ago. Lower blaze grown over.

DESCRIBE CORNER LOCATION RELATIVE TO NEAR-BY FEATURES, ALSO HOW TO REACH CORNER

Corner falls on open timbered South slope approximately 5 feet East of a North-South fenceline and 300 feet South of a private road.

PHOTO IDENTIFICATION DATA

Photo No. 1487-25  
Filed At. Ranger Office  
Object Ident. As shown  
Ident. By D.I. Griffith  
*Signature*

PLANE COORDINATE POSITION DATA

State \_\_\_\_\_ Zone \_\_\_\_\_  
X \_\_\_\_\_  
Y \_\_\_\_\_  
Estab. By \_\_\_\_\_

*Signature* \_\_\_\_\_ Title SURVEYOR Division \_\_\_\_\_ Headquarters \_\_\_\_\_ Date 9-7-88 Agency \_\_\_\_\_

FS-7100-52 (3/68)

**CORNER RECORD (PERPETUATION)**

**MONUMENT: DESCRIBE NEW MONUMENT SET, OR WORK DONE TO PRESERVE EXISTING MONUMENT**

Rebuilt mound of stone around monument, 3 ft. base to top of cap.

**ACCESSORIES : DESCRIBE NEW BT'S WITNESS OBJECTS ETC. ESTABLISHED, OR WORK DONE TO PRESERVE EXISTING EVIDENCE**

Painted a 6 inch red band around all bearing trees and attached 54-3 and 54-9 signs.  
Set steel fencepost approximately 5 feet North with 54-2 and 54-9 signs attached.

Work Done By D.I. Griffith Title Surveyor Date 9-2-88 State Registration No. OPLS 644  
or Agency

Certified Cor. Record Prepared ? Yes  No  Filed At: \_\_\_\_\_ Date \_\_\_\_\_

**REMARKS**

Witnesses: Rick Robinson and Jeff Petersen

Index File No. N-21 T. 55 R. 30E W.M. Tract or Surv. No. \_\_\_\_\_ Cor. \_\_\_\_\_


Index  
 File No. N-21  
 T 5 S. R. 30 E.  
 Merid. Will.

**CORNER RECORD (SEARCH)**

(Ref. FSM 7151.4)

Tract or Survey No. \_\_\_\_\_ Cor. No. \_\_\_\_\_  
 R.D. Ukiah County Umatilla  
 N.F. Umatilla State Ore.

**CORNER DIAGRAM**

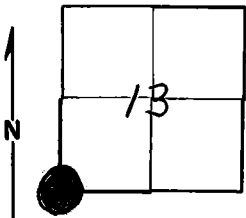

**DESCRIBE CORNER MONUMENT FOUND**

*Monumented by BLM, 1978*

**DESCRIBE BEARING TREES OR OTHER OFFICIAL ACCESSORIES FOUND**

30" D.B.H. Pond. Pine brs. S. 38° E. 10 lks.  
 30" D.B.H. Pond. Pine brs. S. 18° W. 83 lks.

Other B.t.s were possibly destroyed by fire,  
 also found metal posters

**PHOTO IDENTIFICATION DATA**

Photo No. \_\_\_\_\_  
 Filed At. \_\_\_\_\_  
 Object Ident. \_\_\_\_\_  
 Ident. By \_\_\_\_\_

*Signature*

**PLANE COORDINATE POSITION DATA**

State \_\_\_\_\_ Zone \_\_\_\_\_  
 X \_\_\_\_\_  
 Y \_\_\_\_\_  
 Estab. By \_\_\_\_\_

*Agency*

**DESCRIBE CORNER LOCATION RELATIVE TO NEAR-BY FEATURES, ALSO HOW TO REACH CORNER**

Signature  
*melvin Christian*

Title

Division

Headquarters

Date

7100-52-(3/68)

*Ukiah*

*5-25-73*

CORNER RECORD (PERPETUATION)

MONUMENT: DESCRIBE NEW MONUMENT SET, OR WORK DONE TO PRESERVE EXISTING MONUMENT

ACCESSORIES : DESCRIBE NEW BT'S WITNESS OBJECTS ETC. ESTABLISHED, OR WORK DONE TO PRESERVE EXISTING EVIDENCE

Work Done By \_\_\_\_\_ Title \_\_\_\_\_ Date \_\_\_\_\_ State Registration No. or Agency \_\_\_\_\_

Certified Cor. Record Prepared ? Yes No Filed At: \_\_\_\_\_ Date \_\_\_\_\_

REMARKS

Index File No. *N-21* T. R. M. Tract or Surv. No. Cor.