


CERTIFIED RECORD OF LAND CORNER MONUMENTATION

History of original corner establishment: Corner established in 1880 by George S. Pershin, under contract No. 361  
40.00 set tamarack post N. E. face of bluff for 1/4 sec. cor.  
A pine 8 in. diam. brs. N. 24° W. 19 lks dist.  
A pine 6 in. diam. brs. S. 52° W. 11 lks dist.

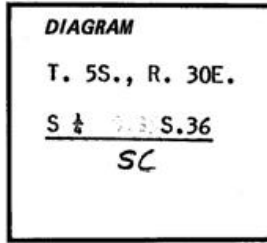

No record of subsequent remonumentation found in County Record.

Description of corner evidence found:


NONE

Description of monument and accessories established to perpetuate the original location of this corner:

Set 2 1/2" X 30" iron pipe 27" in ground with brass cap marked as shown: from which I scribed new Bearing Trees.

A 24" fir bears N. 69° 12' W. 53.80 ft. marked T. 5 N., R. 30 E., 1/4 S.36 SC BT  
A 16" pipe bears N. 31° 58' E. 41.30 ft. marked T. 5 N., R. 30 E., 1/4 S. 36 SC BT

I nailed a brass washer marked PLS 933 to the BT blaze of both trees. Set a steel fence post 3 ft. East of corner. Corner is 13 ft. North of East-west old fence line. Used transit and steel tape, measuring to the center of new BTs.

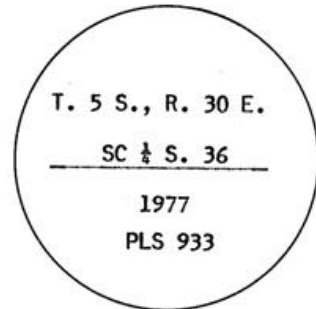

Office of.....County Surveyor..... County of.....Umatilla.....  
State of.....Oregon....., I hereby certify that the within instrument was filed in this office  
for record on the..... day of....., 19.....  
*David H. Krumbein* by .....  
(COUNTY OFFICIAL) (DEPUTY)