

USDA-FOREST SERVICE

Index File No. S-4

T 5S R. 3TE

Merid. Willamette

CORNER RECORD (SEARCH)

(Ref. FSM 7151.4)


Tract or Survey No. Sec 30

Cor. No. NE 1/16

R.D. Ukiah County Umatilla

N.F. Umatilla State Oregon

CORNER DIAGRAM

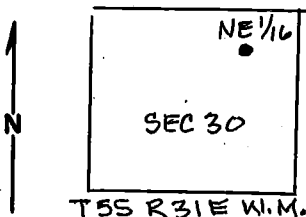

DESCRIBE CORNER MONUMENT FOUND

None

DESCRIBE BEARING TREES OR OTHER OFFICIAL ACCESSORIES FOUND

None

PHOTO IDENTIFICATION DATA

Photo No. \_\_\_\_\_

Filed At. \_\_\_\_\_

Object Ident. \_\_\_\_\_

Ident. By \_\_\_\_\_

*Signature*

PLANE COORDINATE POSITION DATA

State \_\_\_\_\_ Zone \_\_\_\_\_

X \_\_\_\_\_

Y \_\_\_\_\_

Estab. By \_\_\_\_\_

*Agency*

DESCRIBE CORNER LOCATION RELATIVE TO NEAR-BY FEATURES, ALSO HOW TO REACH CORNER

From location marker on fence post where fence crosses road walk west along fence 1500 ft. +.

A fence corner where fences go north and east bears SE 41 ft.

Corner is located on the level on top of wide ridge at the North end of a large opening.

*Signature*  
Willie R. Wells

Title  
PLS 1106

Division

Headquarters

Date  
8/21/79

7100-52-(3/68)

CORNER RECORD (PERPETUATION)

MONUMENT: DESCRIBE NEW MONUMENT SET, OR WORK DONE TO PRESERVE EXISTING MONUMENT

Set a 2" x 30" galvanized iron pipe with a brass cap 6" in ground with a mound of stone around it marked:

T5S R31E

Set a steel fence post South and West on line from corner and attached signs 54-2 and 54-9.

NE 1/16 S30

1979

PLS 1106

9

ACCESSORIES: DESCRIBE NEW BT'S WITNESS OBJECTS ETC. ESTABLISHED, OR WORK DONE TO PRESERVE EXISTING EVIDENCE

A 10 1/2" bull pine bears N28 1/2° E 223.5 ft. to center scribed NE 1/16 S 30 BT.

A 1 3/4" bull pine bears N48 1/2° E 228.3 ft. to center scribed NE 1/16 S 30 BT.

BT's have a lower blaze scribed BT with a brass washer stamped PLS 1106 nailed flush.

Attached signs 54-3 and 54-4 and painted red ring around BTS.

10

Work Done By: William R. Wells Title PLS Date 8/21/79 State Registration No. 1106  
or Agency  
Certified Cor. Record Prepared? Yes  No  Filed At: Umatilla County Surveyor's Office Date

11

REMARKS

Witnesses: Greg Flowers L.S.I.T.  
Brent Reynolds

12