

Index  
File No. Z-3

CORNER RECORD (SEARCH)

(Ref. FSM 7.151.4)

Tract or Survey No. \_\_\_\_\_ Cor. No. \_\_\_\_\_


T 5S R. 32E

R.D. UKIAH County UMATILLA

Merid. WILLAMETTE

N.F. UMATILLA State OREGON

CORNER DIAGRAM

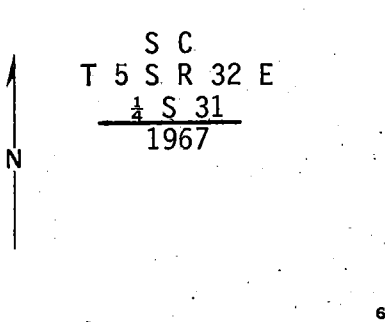

DESCRIBE CORNER MONUMENT FOUND

Found an iron pipe, firmly set, 2½ ins. diam., in a mound of stone, 3 ft. base, to top, with brass cap mkd.

U.S. Dept. of Interior  
Bureau of Land Management

S C  
T 5 S R 32 E  
1/4 S 31  
1967

DESCRIBE BEARING TREES OR OTHER OFFICIAL ACCESSORIES FOUND

A Ponderosa Pine, 25 ins. diam., bears N. 27½°E., 85½ lks. dist., scribing visible on partially healed blaze.  
A Ponderosa Pine, 10 ins. diam., bears N. 35°W., 100½ lks. dist., scribing visible on partially healed blaze.

PHOTO IDENTIFICATION DATA

Photo No. 280-293  
Filed At UMATILLA NAT. FOR  
Object Ident. DIRECT  
Ident. By [Signature]  
*Schroeder*

DESCRIBE CORNER LOCATION RELATIVE TO NEAR-BY FEATURES, ALSO HOW TO REACH CORNER

PLANE COORDINATE POSITION DATA

State \_\_\_\_\_ Zone \_\_\_\_\_  
X \_\_\_\_\_  
Y \_\_\_\_\_  
Etab. By \_\_\_\_\_

[Signature]  
Agency  
Signature

Title LS 1099 Division \_\_\_\_\_ Headquarters \_\_\_\_\_ Date 9-18-84 FS-7100-52 (3/68)

CORNER RECORD (PERPETUATION)

MONUMENT: DESCRIBE NEW MONUMENT SET, OR WORK DONE TO PRESERVE EXISTING MONUMENT

None

ACCESSORIES: DESCRIBE NEW ST'S WITNESS OBJECTS ETC. ESTABLISHED, OR WORK DONE TO PRESERVE EXISTING EVIDENCE

None

Work Done By Gary Langlitz Title LS 1099 Date 8-84 State Registration No. or Agency \_\_\_\_\_

Certified Cor. Record Prepared? Yes  No  Filed At: \_\_\_\_\_ Date \_\_\_\_\_

REMARKS

Corner of fences N-E-W is 24' East and 13' South.

Index File No. Z-3 T. 5S R. 32E M. WILLAMETTE Tract or Surv. No. \_\_\_\_\_ Cor. \_\_\_\_\_