

USDA-FOREST SERVICE

Index
File No. B-15

CORNER RECORD (SEARCH)

(Ref. FSM 7151.4)

Tract or Survey No. _____ Cor. No. _____

T 58 R. 33E

R.D. Ukiah County Umatilla

Merid. W.M.

N.F. Umatilla State Or.

CORNER DIAGRAM



CN 1/16 S3

DESCRIBE CORNER MONUMENT FOUND

2 1/8" iron pipe with brass cap mkd:

T58 R33E
CN 1/16
S3
1975
PLS 644

DESCRIBE BEARING TREES OR OTHER OFFICIAL ACCESSORIES FOUND

Lodgepole, 8", dead & down, stump bears N21°W,
6.2 ft.
Lodgepole, 7", dead & down, root hole
bears S23°W, 24.7 ft.

PHOTO IDENTIFICATION DATA

Photo No. _____
Filed At. _____
Object Ident. _____
Ident. By _____
Signature

DESCRIBE CORNER LOCATION RELATIVE TO NEAR-BY FEATURES, ALSO HOW TO REACH CORNER

Cor. falls on NE slope in open NE of 5440 rd.
BTs are visible from rd.

PLANE COORDINATE POSITION DATA

State _____ Zone _____
X _____
Y _____
Estab. By _____
Agency

Signature
F. L. Munro

Title L.S. Division _____ Headquarters _____

Date 9/26/84

7100-52-(3/68)

CORNER RECORD (PERPETUATION)

MONUMENT: DESCRIBE NEW MONUMENT SET, OR WORK DONE TO PRESERVE EXISTING MONUMENT

None.

ACCESSORIES: DESCRIBE NEW BT'S WITNESS OBJECTS ETC. ESTABLISHED, OR WORK DONE TO PRESERVE EXISTING EVIDENCE

Tamarack, 9", S27 1/4° E, 67.0 ft.
Tamarack, 7", S49° W, 117.0 ft.

BTs have reqd. paint, tags & signs.

Work Done By F.S. Munro Title L.S. Date 9/16/84 State Registration No. 1832
for Agency

Certified Cor. Record Prepared? Yes No Filed At: Hmatilla Co. Surveyor Date

REMARKS

Index File No. B-15 T. 58 R. 33E M. W.M. Tract or Surv. No. Cor. 13

Index
File No. B-15

CORNER RECORD (SEARCH)

(Ref. FSM 7151.4)

Tract or
Survey No. B-15

T 55 R. 33E


R.D. UKIAH County UMATILLA

Merid. WM

N.F. UMATILLA State ORE

CORNER DIAGRAM

DESCRIBE CORNER MONUMENT FOUND

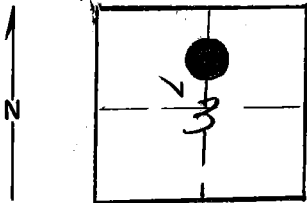

NONE

DESCRIBE BEARING TREES OR OTHER OFFICIAL ACCESSORIES FOUND

NONE

PHOTO IDENTIFICATION DATA

Photo No. _____

Filed At. _____

Object Ident. _____

Ident. By _____

Signature

PLANE COORDINATE POSITION DATA

State _____ Zone _____

X _____

Y _____

Estab. By _____

Agency

6

DESCRIBE CORNER LOCATION RELATIVE TO NEAR-BY FEATURES, ALSO HOW TO REACH CORNER

3

Signature

Title

Division

Headquarters

Date

7400-52 (3/68)

4

5

33 *DJ K... [Signature]*

SURVEYOR

12/75

CORNER RECORD (PERPETUATION)

MONUMENT: DESCRIBE NEW MONUMENT SET, OR WORK DONE TO PRESERVE EXISTING MONUMENT

SET 2 1/2" X 30" IRON PIPE WITH BRASS CAP

9

ACCESSORIES : DESCRIBE NEW BT'S WITNESS OBJECTS ETC. ESTABLISHED, OR WORK DONE TO PRESERVE EXISTING EVIDENCE

NEW BT'S

A 9" LODGE POLE PINE N17W, 6.2 FT

A 8" " " " S25W, 24.7 FT

10

Work Done By D.I. GRIFFITH Title SURVEYOR Date 12/75 State Registration No. or Agency ORE DLS 69A

Certified Cor. Record Prepared? Yes No Filed At: UMATILLA CO. CT. HQ. Date 12/75

11

REMARKS

SEE MAP OF SURVEY DATED DEC. 1975

12

Index File No. B-15 T.5S

R. 33 E WM.

Tract or Surv. No.

Cor. B-15 13