

USDA-FOREST SERVICE

Index File No. E-25

CORNER RECORD (SEARCH)

(Ref. FSM 7151.4)

Tract or Survey No.

Cor. No. Sec.

T 5S R. 33E

R.D. Ukiah

County

Umatilla


Merid. Willamette

N.F. Umatilla

State

Oregon

CORNER DIAGRAM

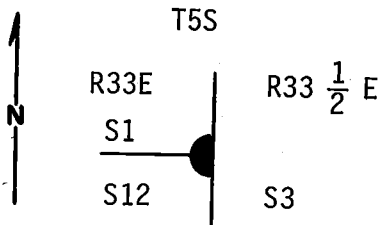

DESCRIBE CORNER MONUMENT FOUND

Umatilla Co. Record Survey No. H-50-B shows finding the original stone and BTs. In place of stone a 2"x36" galvanized pipe was set along with two new BTs. I found the said 2"x36" galvanized pipe.

DESCRIBE BEARING TREES OR OTHER OFFICIAL ACCESSORIES FOUND

Fnd. Pine 26" dia. bearing N80E, 59.4 ft. with open blaze and visible scribing "R34E S6". Found Pine 24" dia. down and dead bearing S760W, 91.1 ft. with visible scribing T5S R33E S2 BT. Fnd. L.P. Pine (dead standing) 12" dia. bearing N190W, 35.7 ft. scribed T5S R33E S1 BT. L.P. Pine (dead standing) 7" dia. bearing S60W, 21.6 ft. scribed T5S R33E S12 BT.

PHOTO IDENTIFICATION DATA

Photo No.

Filed At.

Object Ident.

Ident. By

Signature

PLANE COORDINATE POSITION DATA

State Zone

X

Y

Estab. By

Agency

Signature

DESCRIBE CORNER LOCATION RELATIVE TO NEAR-BY FEATURES, ALSO HOW TO REACH CORNER

Corner falls 10 ft. south of U.S.F.S. Road No. 5160-290

Title

Division ORLS

Headquarters 1294

Date 9/77

7100-52-(3/68)

CORNER RECORD (PERPETUATION)

MONUMENT: DESCRIBE NEW MONUMENT SET, OR WORK DONE TO PRESERVE EXISTING MONUMENT

In place of found 2"x36" galvanized pipe, set 2½"x30" galvanized pipe with brass cap stamped:

	T5S		
R33E		R33	1/2 E
S1			2
<hr/>			
S2		S3	
1980			
OR PLS 1294			

Set pipe 24" in ground with mound of stone to cap.

ACCESSORIES : DESCRIBE NEW BT's WITNESS OBJECTS ETC. ESTABLISHED, OR WORK DONE TO PRESERVE EXISTING EVIDENCE

New BTs. A Lodge Pole Pine 6" dia. bears N52°W, 28.8 ft., scribed T5S R33E S1 BT. A Lodge Pole Pine 8" dia. bears S31°W, 53.0 ft., scribed T5S R33E S12 BT. Attached 54-3 and 54-4 signs to all BTs. Attached brass washer stamped LS1294 to foot blaze of new BTs. Painted blazes and 6" band around all BTs. Attached 54-2 and 54-4 and 54-5 signs to wood post on south side of U.S.F.S. Road No. 5160-290

Work Done By R.C. Orton Title Party Chief Date 6/4/80 State Registration No. or Agency

Certified Cor. Record Prepared? Yes No Filed At: Date

REMARKS

Witnesses: R. Orton
G. Lester
L. Huntsman

Index File No.	T.	R.	M.	Tract or Surv. No.	Cor.	13
<u>E-25</u>	<u>55</u>	<u>33E</u>			U.S. G.P.O. 1977-725-576/586	

Index
File No. E-25

CORNER RECORD (SEARCH)


Tract or
Survey No.

44
Cor.
No.

9
E-25

T 55 R. 33E R.D. Ukiah County Umatilla
Merid. Willamette N.F. Umatilla State Oregon

CORNER DIAGRAM

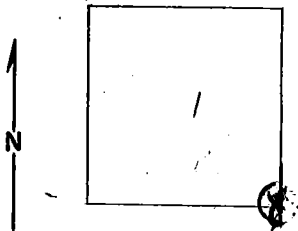

DESCRIBE CORNER MONUMENT FOUND

assumed corner to be a pile of rock.

DESCRIBE BEARING TREES OR OTHER OFFICIAL ACCESSORIES FOUND

BT; S67E, 60'

PHOTO IDENTIFICATION DATA

Photo No. _____
Filed At. _____
Object Ident. _____
Ident. By _____
Signature

PLANE COORDINATE POSITION DATA

State _____ Zone _____
X _____
Y _____
Estab. By _____
Agency

DESCRIBE CORNER LOCATION RELATIVE TO NEAR-BY FEATURES, ALSO HOW TO REACH CORNER

Corner is about 10' S of old road between Lehman Spr. and Frazier GS. There is a section line board and cruiser tag on the road.

Signature

Title

Division

Headquarters

Date

7100-52

REV. 65 5

1st L. Ward

CORNER RECORD (PERPETUATION)

MONUMENT: DESCRIBE NEW MONUMENT SET, OR WORK DONE TO PRESERVE EXISTING MONUMENT

9

ACCESSORIES DESCRIBE NEW BT's WITNESS OBJECTS ETC. ESTABLISHED, OR WORK DONE TO PRESERVE EXISTING EVIDENCE

10

Work Done By _____ Title _____ Date _____ State Registration No. or Agency _____

Certified Cor. Record Prepared? Yes No Filed At: _____ Date _____

11

REMARKS

12

Index File No. F-25 T. R. M. Tract or Surv. No. Cor. _____

13