


USDA-FOREST SERVICE

Index
File No. J-1
T 5S R. 33E
Merid. Willamette

CORNER RECORD (SEARCH)
(Ref. FSM 7151.4)

Tract or Survey No. S 18
Cor. No. NW Cor

R.D. Ukiah County Umatilla
N.F. Umatilla State Oregon

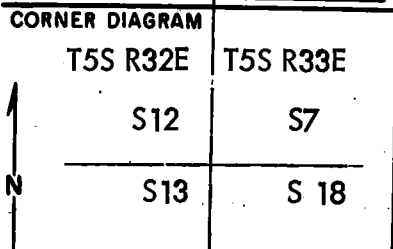

DESCRIBE CORNER MONUMENT FOUND
A mound of stone on North slope West of shallow draw.

DESCRIBE BEARING TREES OR OTHER OFFICIAL ACCESSORIES FOUND
Stump of a pine 30" dia. snag bears N74½°E 37.4 ft. to center scribed T5S R33E S5
A 33" pine bears S14½°E 40.0 ft. to center, healed blaze, has been chopped out & appears to have been chopped too deep.

PHOTO IDENTIFICATION DATA
Photo No. _____
Filed At. _____
Object Ident. _____
Ident. By _____
Signature

DESCRIBE CORNER LOCATION RELATIVE TO NEAR-BY FEATURES, ALSO HOW TO REACH CORNER
A E-W Fence bears North 16.5 ft. from corner
Corner of E.S. & N.S. fence bears N46°E 35 ft from corner
Cable creek Road bears South 450' ± from corner
There are no trees to put a location marker on. Drive 3½ miles ± along Cable Creek Road from Highway 244.

PLANE COORDINATE POSITION DATA
State _____ Zone _____
X _____
Y _____
Estab. By _____
Agency

Signature William R. Wells Title PLS 1106 Division _____ Headquarters _____ Date 7-25-79
7100-52-(3/68)

CORNER RECORD (PERPETUATION)

MONUMENT: DESCRIBE NEW MONUMENT SET, OR WORK DONE TO PRESERVE EXISTING MONUMENT

Set a 2" x 30" galvanized iron pipe 12" in the ground with a mound of stone to the cap marked;

Set a steel fence post North of corner & attached sign 54-4

T5S R32E S 12	T5S R33E S 7
S 13	S 18
1979	
PLS 1106	

ACCESSORIES : DESCRIBE NEW BT'S WITNESS OBJECTS ETC. ESTABLISHED, OR WORK DONE TO PRESERVE EXISTING EVIDENCE

A 13" bullpine bears N4 $\frac{1}{4}$ °W 57.3 to center, marked T5S R32E S12 BT

A 16 $\frac{1}{2}$ " bullpine bears N34°E 51.0 ft. to center, marked T5S R33E S7 BT

A 13 $\frac{1}{2}$ " bullpine bears S63°E 150.0 ft. to center, marked T5S R33E S18 BT

A 10 $\frac{1}{2}$ " bullpine bears S37°W 42.1 ft. to center, marked T5S R32E S13 BT

New BT's have a lower blaze scribed BT with a brass washer, stamped PLS 1106 nailed flush. Attached signs 54-3 & 54-4 and painted red ring around BT's.

Work Done By William R. Wells Title PLS Date 7 25 79 State Registration No. 1106
or Agency

Certified Cor. Record Prepared ? Yes No Filed At: Umatilla County Surveyor's office Date _____

REMARKS

Witnesses: Greg Flowers L.S.I.T.
Brent Reynolds

The ground is very rocky and we could not set monument any deeper.

Index File No.

5^T

33E

M.
Willamette

Tract or Surv. No.
S18

Cor. NW cor 13
13
U.S. G.P.O. 1977-725-576/586

USDA-FOREST SERVICE

Index File No. J-1

CORNER RECORD (SEARCH)

(Ref. FSM 7151.4)

Tract or Survey No. _____ Cor. No. _____


T 5S R. 33E

R.D. Ukiah County Umatilla

Merid. Willamette

N.F. Umatilla State Oregon

CORNER DIAGRAM

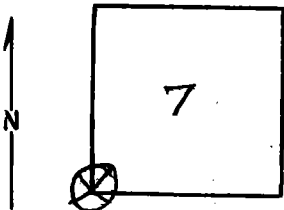

DESCRIBE CORNER MONUMENT FOUND

None.

DESCRIBE BEARING TREES OR OTHER OFFICIAL ACCESSORIES FOUND

NE quadrant: 18" p. pine snag, 10' high blazed SW face, scribed: T5S., R.33E., S 7.
SE quadrant: 31" p. pine chopped north face.
Fence west and north.

PHOTO IDENTIFICATION DATA

Photo No. _____
Filed At. _____
Object Ident. _____
Ident. By _____
Signature

DESCRIBE CORNER LOCATION RELATIVE TO NEAR-BY FEATURES, ALSO HOW TO REACH CORNER

PLANE COORDINATE POSITION DATA

State _____ Zone _____
X _____
Y _____
Estab. By _____
Agency

Signature B. Moore Title Eng. Tech. Division _____ Headquarters _____ Date 7/78 7100-52-(3/68)

CORNER RECORD (PERPETUATION)

GPO 902-673

MONUMENT : DESCRIBE NEW MONUMENT SET, OR WORK DONE TO PRESERVE EXISTING MONUMENT

9

ACCESSORIES : DESCRIBE NEW BT'S WITNESS OBJECTS ETC. ESTABLISHED, OR WORK DONE TO PRESERVE EXISTING EVIDENCE

10

Work Done By _____ **Title** _____ **Date** _____ **State Registration No. or Agency** _____

Certified Cor. Record Prepared ? Yes No **Filed At:** _____ **Date** _____

11

REMARKS

12

Index File No. **T.** **R.** **M.** **Tract or Surv. No.** **Cor.**

13