

U. S. Department of Agriculture
FOREST SERVICE

NATIONAL FOREST

CORNERS OF THE PUBLIC SURVEY

T. 5 S R. 33 E W. 11 Mer.

Section Corner common to Sections

10, 11, 14, and 15

Corner consists of a loose stone (not) in place

State condition _____

Dimensions above ground _____ inches.

Sketch grooves, letters, figures, or notches, on proper face or edge.

CARDINAL POSITION

DIAGONAL POSITION

N W S E

NW SW SE NE

Mound of _____ is located _____

Pits are located _____

Sketch markings of Bearing Trees (or Rocks) in proper box and fill blanks below, giving bearings from Corner to Trees and Distances in Links.

Grown over	T55 R37E S 10		

Species WL DF PP snag

Diameter 18" 24" 18"

Bearing S26E N73E N20W

Distance 36' 45' 60'

Do you believe this to be a genuine Land Office Corner? _____

If not, why? corner stone not definitely located, one loose stone lying near convergence of BTs

G. J. Warren

(Signature)


For and T.M.

(Title)

8/31/54
(Date)

T. 5 R. 33 Well Mer.

(Make sketch of topography near Corner and show section line markers thus "X")

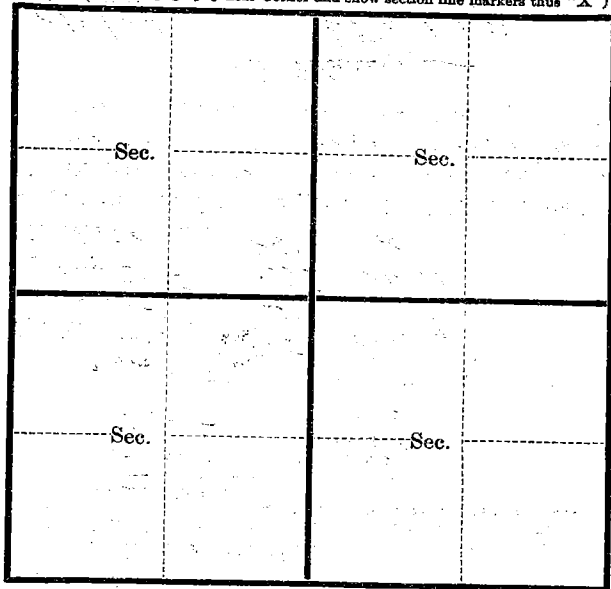

Metal Location Poster is on a _____

tree _____ inches diameter, on the _____

side of _____ from which

this Corner bears _____ Chains.

(Bearing) (Distance)

Section line marker between Secs. _____ and _____ is on

a _____ on the _____

(Tree, post, etc.) (Name of road, trail, etc.)

located _____ chains E, W, N, S., from Sec. Cor.; $\frac{1}{4}$ Cor.; Witness Cor.

(Cross out nonapplicable)

Give any further facts needed to find Corner again:

Index
File No. J-17

CORNER RECORD (SEARCH)
(Ref. FSM 7151.4)

Tract or
Survey No. _____

Cor.
No. J-17


T 55 R. 33E

R.D. UKiah County Umatilla

Merid. with

N.F. Umatilla State Oregon

CORNER DIAGRAM

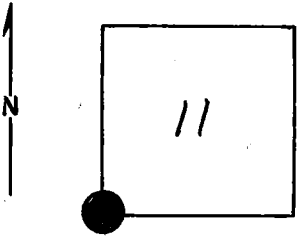

DESCRIBE CORNER MONUMENT ~~FOUND~~ SET

Brass Cap: 1977

DESCRIBE BEARING TREES OR OTHER OFFICIAL ACCESSORIES FOUND

Notes on file! See Monumentation File

PHOTO IDENTIFICATION DATA

Photo No. _____
 Filed At. _____
 Object Ident. _____
 Ident. By _____
Signature

DESCRIBE CORNER LOCATION RELATIVE TO NEAR-BY FEATURES, ALSO HOW TO REACH CORNER

PLANE COORDINATE POSITION DATA

State _____ Zone _____
 X _____
 Y _____
 Estab. By _____
Agency

Signature _____ Title _____ Division _____ Headquarters _____ Date _____

CORNER RECORD (PERPETUATION)

GPO 902-673

MONUMENT: DESCRIBE NEW MONUMENT SET, OR WORK DONE TO PRESERVE EXISTING MONUMENT

9

ACCESSORIES: DESCRIBE NEW BT'S WITNESS OBJECTS ETC. ESTABLISHED, OR WORK DONE TO PRESERVE EXISTING EVIDENCE

10

Work Done By _____ Title _____ Date _____ State Registration No. or Agency _____

Certified Cor. Record Prepared? Yes No Filed At: _____ Date _____

11

REMARKS

12

Index File No. T. R. M. Tract or Surv. No. Cor.

13