

USDA-FOREST SERVICE

Index File No. J-9

CORNER RECORD (SEARCH)

(Ref. FSM 7151.4)

Tract or Survey No. Sec 16

Cor. No. NW COR


T 5S R. 33E

R.D. Ukiah County Umatilla

Merid. Willamette

N.F. Umatilla State Oregon

CORNER DIAGRAM

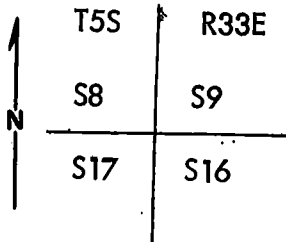

DESCRIBE CORNER MONUMENT FOUND

None

DESCRIBE BEARING TREES OR OTHER OFFICIAL ACCESSORIES FOUND

None

PHOTO IDENTIFICATION DATA

Photo No. _____

Filed At. _____

Object Ident. _____

Ident. By _____

Signature

PLANE COORDINATE POSITION DATA

State _____ Zone _____

X _____

Y _____

Estab. By _____

Agency

DESCRIBE CORNER LOCATION RELATIVE TO NEAR-BY FEATURES, ALSO HOW TO REACH CORNER

From Wiloughby Springs drive North along power line and boundary fence .8 miles to fence corner, at fence corner turn left and drive West along boundary fence .5 miles to fork in road, take the left fork and drive .5 miles to location marker on South side of road on open ridge the corner is 350' South of location poster in open.

Signature

William R. Wells

Title PLS 1106

Division _____

Headquarters _____

Date 7-26-79

7100-52-(3/68)

CORNER RECORD (PERPETUATION)

MONUMENT: DESCRIBE NEW MONUMENT SET, OR WORK DONE TO PRESERVE EXISTING MONUMENT

Set 2" x 30" Iron pipe with a brass cap 10" in ground with a mound of stone to cap marked:

T5S	R33E
S8	S9
S17	S16
1979	
PLS 1106	

Set steel fence post East of Corner and attached signs 54-4 & 54-2

ACCESSORIES: DESCRIBE NEW BT'S WITNESS OBJECTS ETC. ESTABLISHED, OR WORK DONE TO PRESERVE EXISTING EVIDENCE

A 9½" bullpine bears N63°W 73.2 ft to center marked T5S R33E S8 BT

A 14½" bullpines bears N43°E 132.5 ft. to center marked T5S R33E S9 BT

A 11½" bullpine bears S54°E 113.8 ft. to center marked T5S R33E S16 BT

A 11½" bullpine bears S39½°W 86.8 ft. to center marked T5S R33E S17 BT

BT's have a lower blaze with brass washer stamped PLS 1106 nailed flush. Attached signs 54-3 & 54-4 to each BT and painted red ring above upper blaze.

Work Done By William R. Wells Title PLS Date 7 26 79 State Registration No. 1106
or Agency

Certified Cor. Record Prepared? Yes No Filed At: UMATILLA COUNTY SURVEYOR'S OFFICE Date _____

REMARKS

Witnesses: Greg Flowers L.S.I.T. The area is rocky and the trees scrubby & dwarf.
Brent Reynolds

A mound of stone with native post bears S32°E 19.7 ft. This mound has been recently built by Kinzua foresters. We also found an identical mound near the 1/16 corner to the west.

Index File No. J-9


CORNER RECORD (SEARCH)

(Ref. FSM 7151.4)

Tract or Survey No. 5-26 Cor. No. J-9

T 5S R. 33E R.D. Ukiah County Umatilla
 Merid. Willamette N.F. Umatilla State Oregon

CORNER DIAGRAM

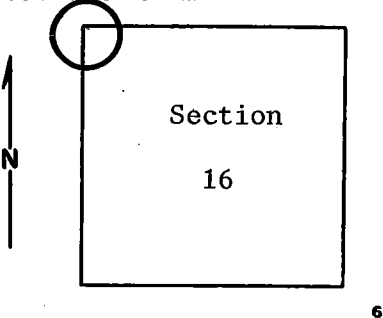

DESCRIBE CORNER MONUMENT FOUND

Material: None.

DESCRIBE BEARING TREES OR OTHER OFFICIAL ACCESSORIES FOUND

Only evidence is an east-west fence.

PHOTO IDENTIFICATION DATA

Photo No. _____
 Filed At. _____
 Object Ident. _____
 Ident. By _____
Signature

PLANE COORDINATE POSITION DATA

State _____ Zone _____
 X _____
 Y _____
 Estab. By _____
Agency

DESCRIBE CORNER LOCATION RELATIVE TO NEAR-BY FEATURES, ALSO HOW TO REACH CORNER

Signature T. Hollamon Title Engineering Technician Division _____ Headquarters S. O. Date April 16, 1974

CORNER RECORD (PERPETUATION)

MONUMENT : DESCRIBE NEW MONUMENT SET, OR WORK DONE TO PRESERVE EXISTING MONUMENT

9

ACCESSORIES : DESCRIBE NEW BT's WITNESS OBJECTS ETC. ESTABLISHED, OR WORK DONE TO PRESERVE EXISTING EVIDENCE

10

Work Done By _____ Title _____ Date _____ State Registration No.
or Agency _____

Certified Cor. Record Prepared ? Yes No Filed At _____ Date _____

11

REMARKS

12

Index File No. T. R. M. Tract or Surv. No. Cor. 13