

USDA-FOREST SERVICE

Index  
File No. L-13  
T 5S R. 33E

CORNER RECORD (SEARCH)


(Ref. FSM 7151.4)

Tract or  
Survey No. Sec 15 Cor. No. W 1/4

Merid. Willamette

R.D. Ukiah County Union  
N.F. Umatilla State Oregon

CORNER DIAGRAM

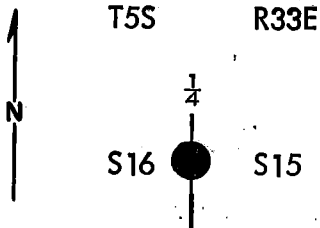

DESCRIBE CORNER MONUMENT FOUND

None set by Survey

DESCRIBE BEARING TREES OR OTHER OFFICIAL ACCESSORIES FOUND

None.

PHOTO IDENTIFICATION DATA

Photo No. \_\_\_\_\_  
Filed At. \_\_\_\_\_  
Object Ident. \_\_\_\_\_  
Ident. By \_\_\_\_\_  
*Signature*

PLANE COORDINATE POSITION DATA

State \_\_\_\_\_ Zone \_\_\_\_\_  
X \_\_\_\_\_  
Y \_\_\_\_\_  
Estab. By \_\_\_\_\_  
*Agency*

DESCRIBE CORNER LOCATION RELATIVE TO NEAR-BY FEATURES, ALSO HOW TO REACH CORNER

Corner is about .2 mi. N. of road that goes from Wiloghby Springs to Hidaway Spring about 40 ft. W. of fence and power line in open field - 100' W of North South road.

Signature

*William R. Wells*

Title

PLS 1106

Division

Headquarters

Date

7-2-79

7100-52-(3/68)

**CORNER RECORD (PERPETUATION)**

**MONUMENT: DESCRIBE NEW MONUMENT SET, OR WORK DONE TO PRESERVE EXISTING MONUMENT**

Set 2" x 30" iron pipe with brass cap set 10" in ground and surrounded with mound T5S R33E  
of stone, marked: 1/4  
Set steel fence post on section line N of corner and attached signs :54-2 and S16 | S15  
54-4 1979 PLS 1106

**ACCESSORIES : DESCRIBE NEW BT'S WITNESS OBJECTS ETC. ESTABLISHED, OR WORK DONE TO PRESERVE EXISTING EVIDENCE**

A 12 1/2" bullpine bears S63°E 123.0 ft. to center, scribed 1/4 S15 BTk

Set 2" x 30" iron pipe with brass cap marked: RM

1/4 S 16  
30.07 →

Reference monument set 20" in ground with mound of stone bears N89°W 30.07 ft. from corner

Work Done By William R. Williams Title PLS Date 7-2-79 State Registration No. 1106  
or Agency

Certified Cor. Record Prepared? Yes  No Filed At: Umatilla County Surveyors Office Date 11

**REMARKS**

Witnesses: Greg Flowers, L.S.I.T.

Brent Reynolds

There is evidence that there has been a North South fence about 20' west of the corner location. The existing fence is 40' E of corner.

Index File No.

5T

33E

M.  
Willamette

Tract or Surv. No.

Sec 15

U.S. G.P.O. 1977-725-576/586

Cor. W 1/4

12

13


Index File No. L-13  
T 5S R. 33E  
Merid. Willamette

**CORNER RECORD (SEARCH)**

Tract or Survey No. 5-36 Cor. No. L-13

R.D. Ukiah County Umatilla  
N.F. Umatilla State Oregon

**CORNER DIAGRAM**

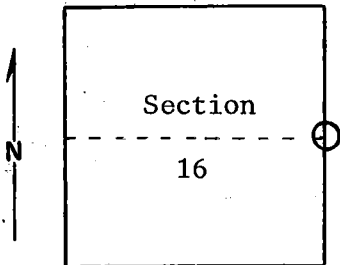

**DESCRIBE CORNER MONUMENT FOUND**

Material: None.

North-south fence only.

**DESCRIBE BEARING TREES OR OTHER OFFICIAL ACCESSORIES FOUND**

A 26-inch p.pine bears east from north-south fence line. Approximately 160 feet from fence. It has an old scar or blaze on west side and may be B.T. (Bears about 50 feet NE from old car body.)

**PHOTO IDENTIFICATION DATA**

Photo No. \_\_\_\_\_  
Filed At. \_\_\_\_\_  
Object Ident. \_\_\_\_\_  
Ident. By \_\_\_\_\_  
*Signature*

**DESCRIBE CORNER LOCATION RELATIVE TO NEAR-BY FEATURES, ALSO HOW TO REACH CORNER**

**PLANE COORDINATE POSITION DATA**

State \_\_\_\_\_ Zone \_\_\_\_\_  
X \_\_\_\_\_  
Y \_\_\_\_\_  
Estab. By \_\_\_\_\_  
*Agency*

Signature: T. Hollamon Title: Engineering Technician Division: \_\_\_\_\_ Headquarters: S. O. Date: April 17, 1974 7100-52 REV. 65 5

**CORNER RECORD ( PERPETUATION )**

**MONUMENT : DESCRIBE NEW MONUMENT SET, OR WORK DONE TO PRESERVE EXISTING MONUMENT**

9

**ACCESSORIES : DESCRIBE NEW BT'S WITNESS OBJECTS ETC. ESTABLISHED, OR WORK DONE TO PRESERVE EXISTING EVIDENCE**

10

**Work Done By.** \_\_\_\_\_ **Title** \_\_\_\_\_ **Date** \_\_\_\_\_ **State Registration No. or Agency** \_\_\_\_\_

**Certified Cor. Record Prepared ?** Yes No **Filed At:** \_\_\_\_\_ **Date** \_\_\_\_\_

11

**REMARKS**

12

**Index File No.**      **T.**      **R.**      **M.**      **Tract or Surv. No.**      **Cor.,**      **13**