

U. S. Department of Agriculture
FOREST SERVICE

Uacville NATIONAL FOREST

CORNERS OF THE PUBLIC SURVEY

T. 5S R. 33E Will. Mer.

1/4 Corner common to Sections
13, and 24

Corner consists of a Stone Md ~~(mark)~~ in place
State condition Fair

Dimensions above ground 5 inches.

Sketch grooves, letters, figures, or notches, on proper face or edge.

CARDINAL POSITION

DIAGONAL POSITION

N	W	S	E

NW	SW	SE	NE

Mound of _____ is located _____

Pits are located _____

Sketch markings of Bearing Trees (or Rocks) in proper box and fill blanks below, giving bearings from Corner to Trees and Distances in Links.

<u>1/4s</u>

<u>1/4s</u>

--

--

<u>BT</u>

<u>BT</u>

--

--

Species PP PP

Diameter 15" 24"

Bearing S62E N07W

Distance 70' 70'

Do you believe this to be a genuine Land Office Corner yes

If not, why? _____

G. Z. Warner


(Signature)

8/31/54
(Date)

For Aid T.M.
(Title)

T. 55 R. 33 Will. Mer.

(Make sketch of topography near Corner and show section line markers thus "X")

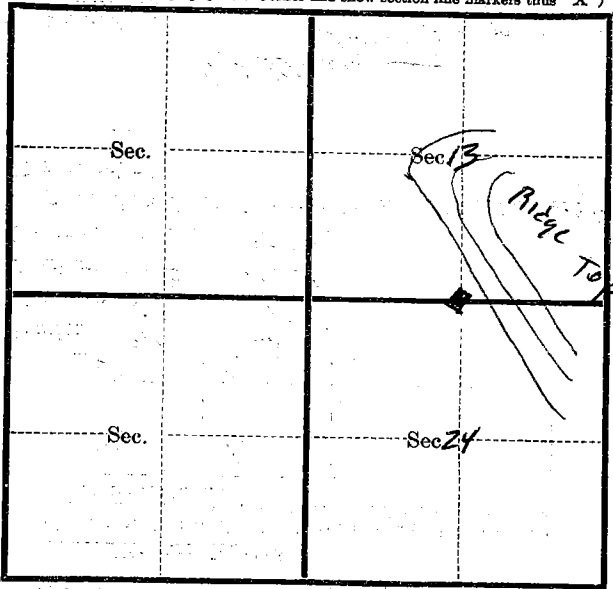

Metal Location Poster is on a pp

tree 16 inches diameter, on the

side of _____ from which

this Corner bears _____ Chains.

(Bearing) (Distance)

Section line marker between Secs. _____ and _____ is on

a _____ on the _____

(Tree, post, etc.) (Name of road, trail, etc.)

located _____ chains E, W, N, S., from Sec. Cor.; 1/4 Cor.; Witness Cor.

(Cross out nonapplicable)

Give any further facts needed to find Corner again:

Corner is on old fence-row,
approx 70-80 feet in elevation below
the top of ridge to the east.

USDA-FOREST SERVICE

Index
File No. N-23

CORNER RECORD (SEARCH)

(Ref. FSM 7151.4)

Tract or
Survey No. _____
Cor. No. N-23


T 55 R. 33E

R.D. Ukiah County Umatilla

Merid. Will

N.F. Umatilla State Oregon

CORNER DIAGRAM

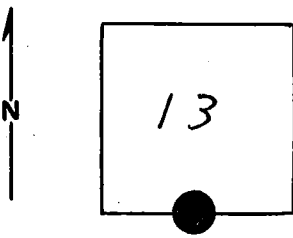

DESCRIBE CORNER MONUMENT ~~FOUND~~ SET

Brass Cap! 1977

DESCRIBE BEARING TREES OR OTHER OFFICIAL ACCESSORIES FOUND

Notes on file: see monumentation file

PHOTO IDENTIFICATION DATA

Photo No. _____
Filed At. _____
Object Ident. _____
Ident. By _____
Signature

DESCRIBE CORNER LOCATION RELATIVE TO NEAR-BY FEATURES, ALSO HOW TO REACH CORNER

PLANE COORDINATE POSITION DATA

State _____ Zone _____
X _____
Y _____
Estab. By _____
Agency

Signature _____ Title _____ Division _____ Headquarters _____ Date _____

CORNER RECORD (PERPETUATION)

MONUMENT : DESCRIBE NEW MONUMENT SET, OR WORK DONE TO PRESERVE EXISTING MONUMENT

9

ACCESSORIES : DESCRIBE NEW BT'S WITNESS OBJECTS ETC. ESTABLISHED, OR WORK DONE TO PRESERVE EXISTING EVIDENCE

10

Work Done By _____ Title _____ Date _____ State Registration No. or Agency _____

Certified Cor. Record Prepared ? Yes No Filed At: _____ Date _____

11

REMARKS

12

Index File No. T. R. M. Tract or Surv. No. Cor.

13