

USDA-FOREST SERVICE

Index File No. B-13

CORNER RECORD (SEARCH)

(Ref. FSM 7151.4)

Tract or Survey No. \_\_\_\_\_

Cor. No. N 1/16

T 5S R. 33 1/2E

R.D. Ukiah


County Umatilla

Merid. Willamette

N.F. Umatilla

State Oregon

CORNER DIAGRAM

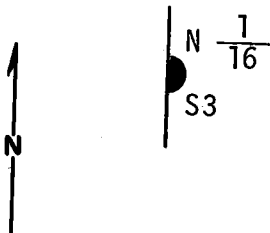

DESCRIBE CORNER MONUMENT FOUND

None Set

DESCRIBE BEARING TREES OR OTHER OFFICIAL ACCESSORIES FOUND

None Set

PHOTO IDENTIFICATION DATA

Photo No. \_\_\_\_\_

Filed At. \_\_\_\_\_

Object Ident. \_\_\_\_\_

Ident. By \_\_\_\_\_

*Signature*

PLANE COORDINATE POSITION DATA

State \_\_\_\_\_ Zone \_\_\_\_\_

X \_\_\_\_\_

Y \_\_\_\_\_

Estab. By \_\_\_\_\_

*Agency*

*Signature*

*Howard D. Davis*

Title

Division  
*ORLS*

Headquarters  
*1294*

Date  
*9-77*

7100-52-(3/68)

4


5

**CORNER RECORD (PERPETUATION)**

**MONUMENT: DESCRIBE NEW MONUMENT SET, OR WORK DONE TO PRESERVE EXISTING MONUMENT**

At surveyed point set 2 1/2" X 30" galvanized pipe with brass cap stamped:

Set pipe 24" in ground with mound of stone to cap.

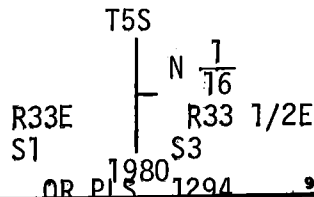

**ACCESSORIES : DESCRIBE NEW BT'S WITNESS OBJECTS ETC. ESTABLISHED, OR WORK DONE TO PRESERVE EXISTING EVIDENCE**

Bearing Trees:

A Ponderosa Pine 13" dia bears N34<sup>0</sup>E, 58.1 ft., scribed N1/16 S3 BT.

A Ponderosa Pine 7 " dia bears N74<sup>0</sup>E, 123.9 ft., scribed N1/16 S3 BT.

Attached 54-3 & 54-4 signs to both BT's. Attached brass washer stamped LS 1294 to foot blaze of both BTs. Painted blazes and 6" band around both BT's R&D. Attached 54-2 & 54-4 signs to metal post 5 ft north of corner. Attached 54-2 and 54-9 to metal post 5 ft east of corner.

10

Work Done By R. C. Orton Title Party Chief Date 7-9-80 State Registration No.                       
 or Agency                     

Certified Cor. Record Prepared ? (Yes )  No  Filed At:                      Date                      11

**REMARKS**

Witnesses: R. Orton  
 L. Huntsman  
 D. Allen

Index File No. B-13 T. 55 R. 33 1/2 E M.                      Tract or Surv. No.                      U.S. G.P.O. Cor. 1977-725-576/586 13