

Index  
File No. E-17

CORNER RECORD (SEARCH)

(Ref. FSM 7151.4)

Tract or  
Survey No. \_\_\_\_\_

Cor.  
No. \_\_\_\_\_

T S3 R. 33 1/2 E

R.D. LaGrande


County Union

Merid. Willamette

N.F. W-W

State Oregon

CORNER DIAGRAM

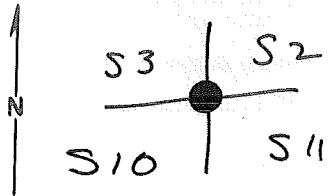

DESCRIBE CORNER MONUMENT FOUND

Original sandstone, 16x12x4", mtd w/2 notches on E. and 5 notches on S edges

DESCRIBE BEARING TREES OR OTHER OFFICIAL ACCESSORIES FOUND

A pine, 25" dia, bears S67E, 26 lks, w/ scribe marks  
33 1/2 E S11 BT visible.

A fir, 25" dia, brs S70W, 40 lks w/ scribe marks  
33 1/2 E visible on open blaze.

PHOTO IDENTIFICATION DATA

Photo No. \_\_\_\_\_  
Filed At. \_\_\_\_\_  
Object Ident. \_\_\_\_\_  
Ident. By \_\_\_\_\_  
*Signature*

PLAN E COORDINATE POSITION DATA

State \_\_\_\_\_ Zone \_\_\_\_\_  
X \_\_\_\_\_  
Y \_\_\_\_\_  
Estab. By \_\_\_\_\_  
*Agency*

Signature

Title

Division

Headquarters

Date

7100-52 (3, 68)

CORNER RECORD (PERPETUATION)

MONUMENT: DESCRIBE NEW MONUMENT SET, OR WORK DONE TO PRESERVE EXISTING MONUMENT

Set Brass Cap Mkd: TSS R33 1/2 E  
 S3 | S2  
 S10 | S11  
 1977

ACCESSORIES: DESCRIBE NEW BT'S WITNESS OBJECTS ETC. ESTABLISHED, OR WORK DONE TO PRESERVE EXISTING EVIDENCE

Grand fir, 10" dia, brs. N31E, 64 lbs dist. mkd TSS R33 1/2 E S2 BT  
 Grand fir 10" dia brs N29W, 40 lbs dist, mkd TSS R33 1/2 E, S3 BT

Deposit corner stone alongside iron post.

Work Done By BCM Title \_\_\_\_\_ Date 9-77 State Registration No. \_\_\_\_\_  
 or Agency \_\_\_\_\_

Certified Cor. Record Prepared? Yes No Filed At: \_\_\_\_\_ Date \_\_\_\_\_

REMARKS

USDA-FOREST SERVICE

Index File No. E-17

CORNER RECORD (SEARCH)

(Ref. FSM 7151.4)

Tract or Survey No. \_\_\_\_\_ Cor. No. E-17


T 5S R. 33 1/2E

R.D. Ukiah County \_\_\_\_\_

Merid. Willamette

N.F. Umatilla State Oregon

CORNER DIAGRAM

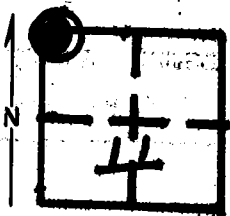

DESCRIBE CORNER MONUMENT FOUND

Material: none Size: none

Height Above Ground: none Condition: none

Markings: none

Skid ~~travel~~ where stone would be

*Trail Brass Cap See Monumentation File*

DESCRIBE BEARING TREES OR OTHER OFFICIAL ACCESSORIES FOUND

21" P. Pine- SE Quadrant with blazed NW face, scribed:

S 33 1/2 E. S 11 BT (location poster by Qard in 1952)

23" Fir in SW Quadrant blazed on NE face, scribed: 33 1/2 S (part of blaze closed.) Stump holes in NW and NE Quadrant fit orig. BT locations.

PHOTO IDENTIFICATION DATA

Photo No. \_\_\_\_\_

Filed At. \_\_\_\_\_

Object Ident. \_\_\_\_\_

Ident. By \_\_\_\_\_

*Signature*

DESCRIBE CORNER LOCATION RELATIVE TO NEAR-BY FEATURES, ALSO HOW TO REACH CORNER

PLANE COORDINATE POSITION DATA

State \_\_\_\_\_ Zone \_\_\_\_\_

X \_\_\_\_\_

Y \_\_\_\_\_

Estab. By \_\_\_\_\_

*Agency*

Signature

*ARUP's*

Title

*Eng. Tech.*

Division

Headquarters

Date

*9/76*

7100-52-(3/68)

### CORNER RECORD (PERPETUATION)

MONUMENT: DESCRIBE NEW MONUMENT SET, OR WORK DONE TO PRESERVE EXISTING MONUMENT

ACCESSORIES : DESCRIBE NEW BT'S WITNESS OBJECTS ETC. ESTABLISHED, OR WORK DONE TO PRESERVE EXISTING EVIDENCE

9

10

Work Done By \_\_\_\_\_ Title \_\_\_\_\_ Date \_\_\_\_\_ State Registration No. or Agency \_\_\_\_\_

Certified Cor. Record Prepared ? Yes No Filed At: \_\_\_\_\_ Date \_\_\_\_\_

11

#### REMARKS

12

13

Index File No. T. R. M. Tract or Surv. No. Cor.