

History of original corner establishment:


Corner established in 1882 by Rufus S. Moore under Contract No. 451.

39.89 chains set stone 15" x 10" x 3".

A pine 20" diameter bears North 43° West 9 lks. dist.

A pine 8" diameter bears South 65° East 78 lks. dist.

No record of subsequent remonumentation found in County Records.

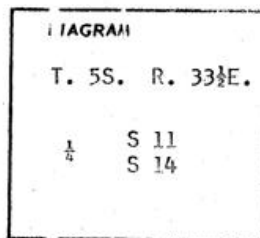

Description of corner evidence found:


None.

Description of monument and accessories established to perpetuate the original location of this corner

Set 2 1/2" x 30" iron pipe 15" in ground with stone mound raised around brass cap marked as shown: I scribed new Bearing Trees.

A fir 10" diameter bears South 09°38' West 24.00 feet marked 1/4 S 11 BT
A fir 9" diameter bears North 23°40' West 4.5 feet marked 1/4 S 14 BT.

I nailed a brass washer marked PLS 933 to the BT blaze of both trees. Set steel fence post 5 feet East of corner. The corner is 575 feet West of North-South Road. Used T-2 and steel tape, measuring a horizontal distance to center of Bearing Trees.

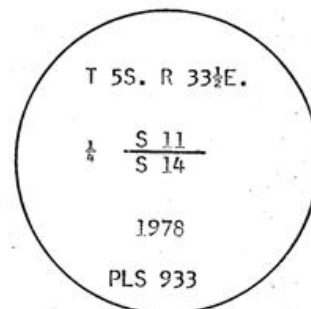

Office of County Surveyor County of Umatilla
 State of Oregon, I hereby certify that the within instrument was filed in this office
 for record on the day of
 _____ by _____
 (COUNTY OFFICIAL) (DEPUTY)

J-19

Q-796