

USDA-FOREST SERVICE

Index File No. J-21

CORNER RECORD (SEARCH)

(Ref. FSM 7151.4)

Tract or Survey No. _____ No. J-21


T 5S R. 33½E

R.D. Ukiah County Umatilla

Merid. Willamette

N.F. Umatilla State Oregon

CORNER DIAGRAM

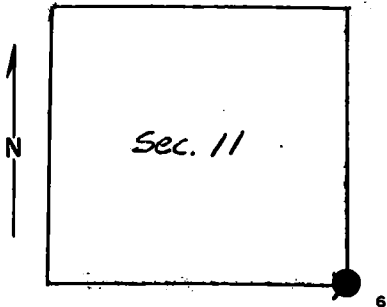

DESCRIBE CORNER MONUMENT FOUND

None

DESCRIBE BEARING TREES OR OTHER OFFICIAL ACCESSORIES FOUND

None

PHOTO IDENTIFICATION DATA

Photo No. _____

Filed At. _____

Object Ident. _____

Ident. By _____

Signature

PLANE COORDINATE POSITION DATA

State _____ Zone _____

X _____

Y _____

Estab. By _____

Agency

DESCRIBE CORNER LOCATION RELATIVE TO NEAR-BY FEATURES, ALSO HOW TO REACH CORNER

From intersection of Roads S552 and S534, which is 800 feet West of Frazier Guard Station, go South on road S534 0.1 mile to road up Frazier Creek. Then go about 1 mile to fork in road. Take right fork and go 0.5 mile. The corner is 50 feet East of road on West slope.

Signature

Terry C. Hamby

Title

Division

O.P.L.S.

Headquarters

1638

Date

8/78

7100-52-(3/68)

5

CORNER RECORD (PERPETUATION)

MONUMENT: DESCRIBE NEW MONUMENT SET, OR WORK DONE TO PRESERVE EXISTING MONUMENT

T 5S R 33 1/2 E

Set 2 1/2" x 30" iron pipe with brass cap.

S 11 | S 12

Stamped:

S 14 | S 13

1978

PLS 933

9

ACCESSORIES : DESCRIBE NEW BT's WITNESS OBJECTS ETC. ESTABLISHED, OR WORK DONE TO PRESERVE EXISTING EVIDENCE

Fir 12" diameter bears North 17°42' West 29.20 feet with signs 54-3 and 54-4.
Tamarack 18" diameter bears North 38°50' East 9.50 feet with signs 54-3 and 54-4.
Tamarack 12" diameter bears South 57°32' East 3.00 feet with signs 54-3 and 54-4.
Fir 24" diameter bears South 32°00' West 9.00 feet with signs 54-3 and 54-4.

Set steel post 5 feet East of corner with 54-4. Painted red band around tree.

10

Work Done By T. Hamby Title Surveyor Date 7/25/78 State Registration No. 0.P.L.S. 1638
or Agency

Certified Cor. Record Prepared ? Yes No Filed At: Umatilla County Surveyor Date 8-8-78

11

REMARKS

Witness by Richard Barton and William Hampton.

Index File No.

T.

R.

M.

Tract or Surv. No.

Cor.

12

13