

U. S. Department of Agriculture
FOREST SERVICE

Umetille NATIONAL FOREST

CORNERS OF THE PUBLIC SURVEY

T. 55 R. 33 1/2 Will. Mer.

1/4 Corner common to Sections
14, and 23

Corner consists of a Not Found (not) in place
State condition

Dimensions above ground _____ inches.

Sketch grooves, letters, figures, or notches, on proper face or edge.

CARDINAL POSITION

DIAGONAL POSITION

N W S E NW SW SE NE

Mound of _____ is located _____

Pits are located _____

Sketch markings of Bearing Trees (or Rocks) in proper box and fill blanks below, giving bearings from Corner to Trees and Distances in Links.

<u>Grown</u>
<u>over</u>

<u>1/4</u>
<u>S</u>
<u>BT</u>

Species DF PP. S. Neg.

Diameter 32" 30"

Bearing S57 W N62 W

Distance 33' 25'

Do you believe this to be a genuine Land Office Corner? _____


If not, why? _____

8/31/54
(Date)

AJ Warren
(Signature)
For and TM
(Title)

T. _____ R. _____ Mer.

(Make sketch of topography near Corner and show section line markers thus "X")

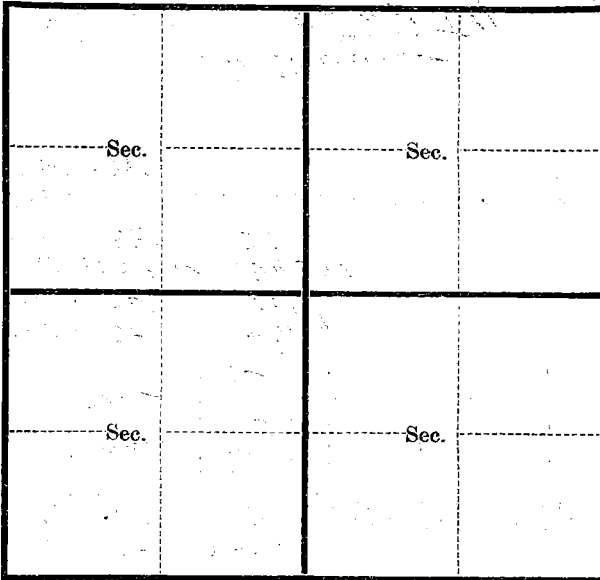

Metal Location Poster is on a _____

tree _____ inches diameter, on the _____

side of _____ from which

this Corner bears _____ Chains.

(Bearing) (Distance)

Section line marker between Secs. _____ and _____ is on

a _____ on the _____

(Tree, post, etc.)

(Name of road, trail, etc.)

located _____ chains E, W, N, S., from Sec. Cor.; 1/4 Cor.; Witness Cor.

(Cross out nonapplicable)

Give any further facts needed to find Corner again:

USDA-FOREST SERVICE

Index File No. N-19


CORNER RECORD (SEARCH)
(Ref. FSM 7151.4)

Tract or Survey No. _____ Cor. No. _____

T 55 R. 33 1/2 E R.D. _____ County _____

Merid. Will N.F. _____ State OREGON

CORNER DIAGRAM

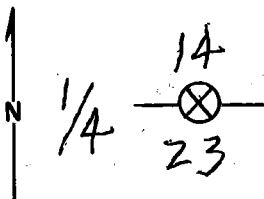

DESCRIBE CORNER MONUMENT FOUND

NONE

DESCRIBE BEARING TREES OR OTHER OFFICIAL ACCESSORIES FOUND

32" DOUG. FIR S 57 W, 33 FT W/HEALED BLZS
30" PONDEROSA PINE SNAG N 62 W, 25' SCRIBED
"1/4 S BT"

PHOTO IDENTIFICATION DATA

Photo No. _____
Filed At. _____
Object Ident. _____
Ident. By _____
Signature

DESCRIBE CORNER LOCATION RELATIVE TO NEAR-BY FEATURES, ALSO HOW TO REACH CORNER

PLANE COORDINATE POSITION DATA

State _____ Zone _____
X _____
Y _____
Estab. By _____
Agency

Signature
A Z WARREN

Title

Division
FORESTER

Headquarters

Date
8/31/54

FS-7100-52 (3/68)

CORNER RECORD (PERPETUATION)

MONUMENT : DESCRIBE NEW MONUMENT SET, OR WORK DONE TO PRESERVE EXISTING MONUMENT

ACCESSORIES : DESCRIBE NEW BT'S WITNESS OBJECTS ETC. ESTABLISHED, OR WORK DONE TO PRESERVE EXISTING EVIDENCE

9

10

Work Done By _____ Title _____ Date _____ State Registration No. or Agency _____

Certified Cor. Record Prepared ? Yes No Filed At: _____ Date _____

11

REMARKS

Index File No. T. R. M. Tract or Surv. No. Cor.

12

13