

Index  
File No. G-13

**CORNER RECORD (SEARCH)**

(Ref. FSM 7151.4)

Tract or Survey No. \_\_\_\_\_ Cor. No. 1/4


T 5 S R. 34 E

R.D. LaGrande County Union

Merid. Willamette

N.F. WW-16 State Oregon

CORNER DIAGRAM

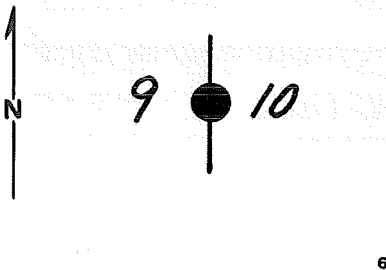

DESCRIBE CORNER MONUMENT FOUND

None

DESCRIBE BEARING TREES OR OTHER OFFICIAL ACCESSORIES FOUND

14" fir stump and log w/healed blaze; opened blaze and found scribing  $\frac{1}{4}$ S BT. (old BT)

PHOTO IDENTIFICATION DATA

Photo No. \_\_\_\_\_

Filed At. \_\_\_\_\_

Object Ident. \_\_\_\_\_

Ident. By \_\_\_\_\_

*Signature*

PLANE COORDINATE POSITION DATA

State \_\_\_\_\_ Zone \_\_\_\_\_

X \_\_\_\_\_

Y \_\_\_\_\_

Estab. By \_\_\_\_\_

*Agency*

DESCRIBE CORNER LOCATION RELATIVE TO NEAR-BY FEATURES, ALSO HOW TO REACH CORNER

Approx. 10 chains S of road S552.

Signature

**Hambleton**

Title

Division

ORLS

Headquarters

645

Date

8-78

7100-52-(3/68)

## CORNER RECORD (PERPETUATION)

MONUMENT: DESCRIBE NEW MONUMENT SET, OR WORK DONE TO PRESERVE EXISTING MONUMENT

Set a 2 $\frac{1}{2}$ " x 30" iron pipe w/brass cap mkd.:  
Buried in large mound of stone and dirt.

T 5 WS

 $\frac{1}{4}$ S 9 $\frac{1}{4}$  S 10

R 34 E

1978

ORLS 645

9

ACCESSORIES: DESCRIBE NEW BT'S WITNESS OBJECTS ETC. ESTABLISHED, OR WORK DONE TO PRESERVE EXISTING EVIDENCE

6" tamarack bears N 09 W, 29.0 feet scribed  $\frac{1}{4}$ S S9 BT w/signs 54-3&4.  
6" fir bears N 78 E, 43.34 feet scribed  $\frac{1}{4}$ S S 10 BT w/ signs 54-3&4.  
Painted blaze and band on BT's red & yellow.  
Set steel fence post by mound of stone w/signs 54-5&6.

10

Work Done By J. Hambleton Title Surveyor Date 8-78 State Registration No. ORLS 645  
or Agency

Certified Cor. Record Prepared? Yes  No  Filed At: Union CS Date \_\_\_\_\_

11

## REMARKS

Witnesses: L. Green  
L. Shirley

12