


J-13


History of original corner establishment:

Original survey by General Land Office contract survey
 The original notes state. Set a post from which;
 A pine 5" in diam bears S86°E 79 lks dist marked T5S R34E S15BT;
 A pine 8" in diam bears S10°W 127 lks dist marked T5S R34E S16BT;
 A pine 7" in diam bears N13°W 90 lks dist marked T5S R34E S9BT;
 A pine 5" in diam bears N39°E 59 lks dist marked T5S R34E S10BT;

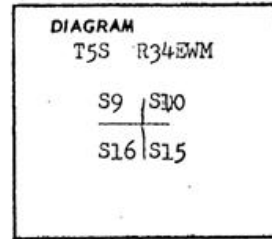

Description of corner evidence found:

Found - A pine 26" in diam bears N39°E 59 lks dist with scribe visible.
 A pine snag 24" in diam bears S10°W 127 lks dist with scribe visible.
 A pine snag 12" in diam bears N13°W 90 lks dist with scribe visible.

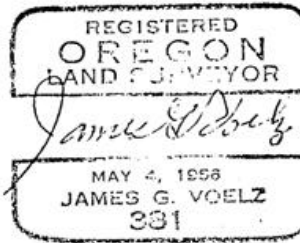

Description of monument and accessories established to perpetuate the original location of this corner

AT the position of the corner I set a 2" galvanized pipe 30" long with a bronze cap on top and a 8" plate welded to bottom. The pipe set to a depth of 6" and raised a stone monument.

I stamped the disk

COR
 T5S R34E
 S9 | S10
 S16 | S15
 ORE LIC 381
 1969

From the monument the original bearing trees are;
 A pine 26" in diam bears N39°E 59 lks dist.
 I set the following new bearing trees;
 A pine 14" in diam bears S45°E 114.8 ft. dist marked T5S R34E S15BT;
 A pine 9" in diam bears S53°W 134.2 ft dist marked T5S R34E S16BT;
 A pine 14" in diam bears N8°W 64.2 ft. dist marked T5S R34E S9BT;
 (distance measured to center of respective trees and marked with scribe)
 I set a steel fence post with USFS sign 54-4 attached. USFS bearing tree signs were placed on bearing trees facing the corner.

Office of County surveyor County of Union
 State of Oregon , I hereby certify that the within instrument was filed in this office
 for record on the 9 day of Sept. 1969, at 10 o'clock P.M., (signed)
 County Surveyor by James G. Voelz
 (COUNTY OFFICIAL) (DEPUTY)

J-13

93-39-B