


History of original corner establishment:

The original subdivision of T5S, R34E was by Rufus S. Moore under Contract No. 451, approved Feb. 1, 1884. He set a post, from which a 9" Pine bears N42°E, 47 lks, a 10" Pine bears N32°W, 20 lks., a 10" Pine bears S58°W, 13 lks., and an 8" Pine bears S22°E, 30 lks.

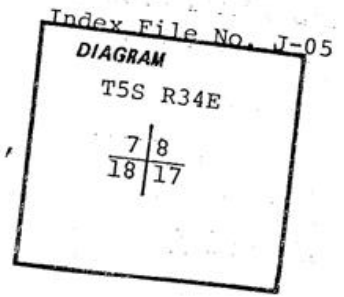

Description of corner evidence found:

Found a 3" brass cap on 2" iron pipe rising 6" above ground. Cap is stamped:

COR
T5S R34E
S7 S8
S18 S17
ORE LIC 381
1969

Bearing Trees Found:

- A 12" L. Pine bears S81°W, 39.5 ft., healed blaze.
- A 23.5" Tamarack bears S40°E, 24.2 ft., healed blaze. (Recorded bearing ; S10°E)
- An 11" Tamarack bears N35°E, 34.4 ft., healed blaze.
- A 20" Tamarack bears N32°W, 13.2 ft., healed blaze.

Description of monument and accessories established to perpetuate the original location of this corner:

Brass LS 1844 disc in lower end of blazes. Painted blazes and attached signs as per Standard Specifications for Cadastral Surveys, USFS Region 6, 1982.

Compass Declination: 19 3/4°E Witness: Duane Scott

Corner is found 500 ft. south of road 5160-630. 0.6 miles from Road 5160-600. Location poster on 6" L. Pine south side of road.

I hereby certify the above described corner monument and/or accessories was established as described in June of 1984.

REGISTERED PROFESSIONAL LAND SURVEYOR
David E. Scott
OREGON
JULY 13, 1972
DAVID E. SCOTT
1844

J-5

Office of..... County of.....
State of....., I hereby certify that the within instrument was filed in this office for record on the..... day of....., 19.....
..... by
(COUNTY OFFICIAL) (DEPUTY)

93-39-B