


Index  
File No. J-7  
T5S R.34E  
Merid. Willamette

CORNER RECORD (SEARCH)

(Ref. FSM 7151.4)

Tract or  
Survey No. \_\_\_\_\_  
Cor.  
No. \_\_\_\_\_

R.D. LaGrande County Umatilla  
N.F. Wallowa Whitman State Oregon

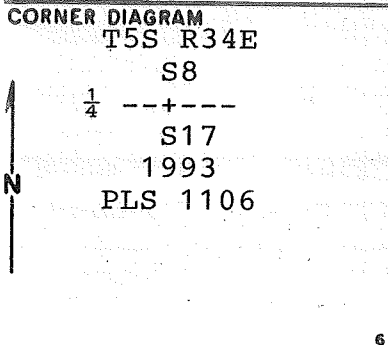

DESCRIBE CORNER MONUMENT FOUND  
None. Re-established corner by single proportion measurement between the NW and NE corners of Section 17.

DESCRIBE BEARING TREES OR OTHER OFFICIAL ACCESSORIES FOUND  
None.

PHOTO IDENTIFICATION DATA

Photo No. \_\_\_\_\_

Filed At. \_\_\_\_\_

Object Ident. \_\_\_\_\_

Ident. By \_\_\_\_\_

*Signature*

DESCRIBE CORNER LOCATION RELATIVE TO NEAR-BY FEATURES, ALSO HOW TO REACH CORNER

Corner is in rock cutbank on East edge of Road No. 5160 and approximately  $\frac{1}{2}$  mile South of the intersection with Road No. 5160-600.

PLANE COORDINATE POSITION DATA

State \_\_\_\_\_ Zone \_\_\_\_\_

X \_\_\_\_\_

Y \_\_\_\_\_

Estab. By \_\_\_\_\_

*Agency*

Signature Walt R Wells Title PLS Division \_\_\_\_\_ Headquarters Pendleton Date 10/22/93 FS-7100-52 (3/68)

**CORNER RECORD (PERPETUATION)**

**MONUMENT: DESCRIBE NEW MONUMENT SET, OR WORK DONE TO PRESERVE EXISTING MONUMENT**

Drove a 5/8" by 30" iron rod with 1 1/2" alum. cap in fractured rock road cut. Cap marked as shown in corner diagram. Attached sign 54-9 to steel fence post, set 4.5 feet East of monument.

**ACCESSORIES : DESCRIBE NEW BT'S WITNESS OBJECTS ETC. ESTABLISHED, OR WORK DONE TO PRESERVE EXISTING EVIDENCE**

A 9 1/2" western larch bears N41°E-114.4 feet, scribed: 1/4S8 BT.  
 A 6" western larch bears N15°W-95.2 feet, scribed: 1/4S8 BT.  
 A 5 1/2" lodgepole pine bears S73°W-42.7 feet, scribed: 1/4S17 BT.  
 A 14" lodgepole pine bears S35°W-124.7 feet, scribed: 1/4S17 BT.  
 A reference monument(5/8"X30" iron pin with 1 1/2" aluminum cap) bears N69°E-19.46 feet, marked: T5SR34E S8 RM 19.46FT 1993 PLS 1106.  
 A reference monument(5/8"X30" iron pin with 1 1/2" aluminum cap) bears

Work Done By WR Wells Title PLS Date \_\_\_\_\_ State Registration No. PLS 1106  
 or Agency \_\_\_\_\_

Certified Cor. Record Prepared ? Yes  No  Filed At: Umatilla Co. Surveyors Office Date 8/94

**REMARKS**

S22 1/2°E-25.45 feet, marked: T5SR34E RM S17 25.45FT 1993 PLS 1106.  
 Bearing trees have brass washer stamped 'PLS 1106' nailed to the face of the blaze, attached sign 54-3 & 54-9, painted face of blaze & a 6" red band around each bearing tree. Reference monuments have sign 54-3 attached to the iron pin, steel guard post with sign 54-9 attached nearby

Index File No. J-7 T. 5S R. 34E M. Williamette Tract or Surv No \_\_\_\_\_ Cor. 13