

Index
File No. J-9


CORNER RECORD (SEARCH)
(Ref. FSM 7151.4)

Tract or Survey No. _____
Cor. S.E. COR.
No. SEC. 8

T 5S R. 34E R.D. LA GRANDE County UNION

Merid. WILLAMETTE N.F. WALLOWA-WHITMAN State OREGON

CORNER DIAGRAM

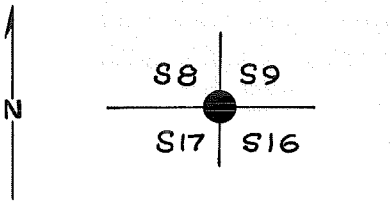

DESCRIBE CORNER MONUMENT FOUND

None

DESCRIBE BEARING TREES OR OTHER OFFICIAL ACCESSORIES FOUND

Found an 8" dead snag at S87°E. 156 Lks.

PHOTO IDENTIFICATION DATA

Photo No. _____
Filed At. _____
Object Ident. _____
Ident. By _____
Signature

DESCRIBE CORNER LOCATION RELATIVE TO NEAR-BY FEATURES, ALSO HOW TO REACH CORNER

From road S447 (Hideway corral)

PLANE COORDINATE POSITION DATA

State _____ Zone _____
X _____
Y _____
Estab. By _____
Agency

Signature	Title	Division	Headquarters	Date	7100-52 (3/68)
<i>J. G. VOELZ</i>	<i>Co. Surveyor</i>			<i>9/69</i>	

CORNER RECORD (PERPETUATION)

MONUMENT: DESCRIBE NEW MONUMENT SET, OR WORK DONE TO PRESERVE EXISTING MONUMENT

Set a 2" galvanized pipe 30" Long with bronze cap on top and an 8" plate welded to bottom. The pipe set to a depth of 24" and back-filled with stone and soil.

9

ACCESSORIES: DESCRIBE NEW BT'S WITNESS OBJECTS ETC. ESTABLISHED, OR WORK DONE TO PRESERVE EXISTING EVIDENCE

*A black pine 8" diam. brs. N.49°E. 152.5 ft. marked T.55. R.34E. S.9B.T.
 A black pine 12" diam. brs. S.84°E. 97.2 ft. marked T.55. R.34E. S.16B.T.
 A black pine 26" diam. brs. S.55°W. 541 ft. marked T.55. R.34E. S.17B.T.
 A black pine 7" diam. brs. N.10°W. 237.4 ft. marked T.55. R.34E. S.8B.T.*

I set a steel fence post with U.S.F.S. sign 54-4 attached. Bearing tree signs were placed on Bearing Trees, Shoulder high, facing the monument. (Distances were measured to center of respective trees and MK'd. with scribe)

10

Work Done By. J. G. VOELZ Title Co. Surveyor Date 9/69 State Registration No. or Agency ORE. LIC. 381

Certified Cor. Record Prepared? Yes No Filed At: LA GRANDE, OREGON Date 9/69

11

REMARKS

12

13

Index
File No. J-9

CORNER RECORD (SEARCH)


Tract or
Survey No. _____ Cor. S.E.
No. SEC. COR

T 5S R. 34E R.D. LA GRANDE County UNION

Merid. WILLAMETTE N.F. WALLOWA-WHITMAN State OREGON

CORNER DIAGRAM

DESCRIBE CORNER MONUMENT FOUND

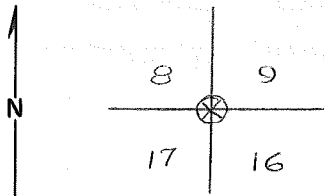

DESCRIBE BEARING TREES OR OTHER OFFICIAL ACCESSORIES FOUND

A POST WAS ERECTED AND PAINTED RED WHICH INDICATES APPROX. CORNER.
B.T. FOR S.16 IS A STANDING SNAG. SCRIBING SHOWS THIS IS THE ONLY B.T. FOUND B.T. WAS PIN-PRICKED IN SAID PHOTO. ENW 3-116

PHOTO IDENTIFICATION DATA

Photo No. _____
Filed At. _____
Object Ident. _____
Ident. By _____
Signature

DESCRIBE CORNER LOCATION RELATIVE TO NEAR-BY FEATURES, ALSO HOW TO REACH CORNER

TO LOCATE - TRAVEL US244 TO FOUR CORNERS JUNCTION, PROCEED S. 2 1/2 miles TO FIRE ROAD 18, THEN S. APPROX. 1 1/2 miles TO JUNCTION OF FIRE ROAD 18 AND S. FLY ROAD, PROCEED S. ON OLD PRIVATE RD. 1/2 MILE - CORNER LOCATED IN NE. EDGE OF A LARGE MEADOW THE CORNER BEARS N. 33° W. FROM A CABIN LOCATED IN THE S.E. EDGE OF THE MEADOW.

PLANE COORDINATE POSITION DATA

State _____ Zone _____
X _____
Y _____
Estab. By _____
Agency

Signature

D. L. BAKER

Title

SURVEY TECH.

Division

LA GRANDE ENGR.

Headquarters

Date

11/15/67

7100-52

REV. 65 5

CORNER RECORD (PERPETUATION)

MONUMENT: DESCRIBE NEW MONUMENT SET, OR WORK DONE TO PRESERVE EXISTING MONUMENT

ACCESSORIES DESCRIBE NEW BT'S WITNESS OBJECTS ETC. ESTABLISHED, OR WORK DONE TO PRESERVE EXISTING EVIDENCE

Work Done By _____ Title _____ Date _____ State Registration No. _____
or Agency _____

Certified Cor. Record Prepared ? Yes No Filed At: _____ Date _____

REMARKS

Index File No. T. R. M. Tract or Surv. No. Cor. 12 13