

Index
File No. K-13

CORNER RECORD (SEARCH)

(Ref. FSM 7151.4)

Tract or Survey No. _____
Cor. No. N-1/16


T 5S R. 39E

R.D. LA GRANDE County UMATILLA N 1/16 OF SECT.

Merid. WM

N.F. W-W State OREGON 16 & 15

CORNER DIAGRAM

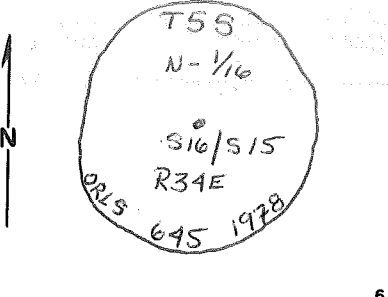

DESCRIBE CORNER MONUMENT FOUND 2 1/2 GALV. PIPE w/ 3" BRASS CAP

DESCRIBE BEARING TREES OR OTHER OFFICIAL ACCESSORIES FOUND

8" LPP BT STUMP (DEAD, BUT STANDING) N60°E 36 FT.
8" LPP BT STUMP (DEAD, BUT STANDING) S45°W 46 FT.

PHOTO IDENTIFICATION DATA

Photo No. _____
Filed At. _____
Object Ident. _____
Ident. By _____
Signature

DESCRIBE CORNER LOCATION RELATIVE TO NEAR-BY FEATURES, ALSO HOW TO REACH CORNER

PLANE COORDINATE POSITION DATA

State _____ Zone _____
X _____
Y _____
Estab. By _____
Agency

Signature EARL E. STRANG Title CET Division LLL Headquarters GREZ Date 6/16/93 7100-52-(3/68)

CORNER RECORD (PERPETUATION)

2100-25 (3-20)

MONUMENT: DESCRIBE NEW MONUMENT SET, OR WORK DONE TO PRESERVE EXISTING MONUMENT

ACCESSORIES : DESCRIBE NEW BT'S WITNESS OBJECTS ETC. ESTABLISHED, OR WORK DONE TO PRESERVE EXISTING EVIDENCE

REPAINTED BLAZE & BANDS ON REMAINING B.T.'S

Work Done By _____ Title _____ Date _____ State Registration No. or Agency _____

Certified Cor. Record Prepared ? Yes No Filed At: _____ Date _____

REMARKS

NEED TO SET NEW B.T.S TO MEET STATE LAW STANDARDS

Index File No. K-13 T. 5 S R. 34E M. WM

Tract or Surv. No.

N 1/16 Cor. of SECT. 16 & 15


Index
File No. ~~1000~~ K-13

CORNER RECORD (SEARCH)
(Ref. FSM 7151.4)

Tract or
Survey No. _____ Cor.
No. N-1/16

T 5 S R. 3/4 E R.D. LaGrande County Union
Merid. Willamette N.F. WW-16 State Oregon

CORNER DIAGRAM

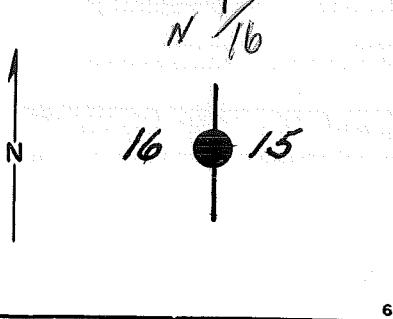

DESCRIBE CORNER MONUMENT FOUND

None

DESCRIBE BEARING TREES OR OTHER OFFICIAL ACCESSORIES FOUND

None

PHOTO IDENTIFICATION DATA

Photo No. _____
Filed At. _____
Object Ident. _____
Ident. By _____
Signature

DESCRIBE CORNER LOCATION RELATIVE TO NEAR-BY FEATURES, ALSO HOW TO REACH CORNER

Approx. 250 ft. S of Fly Creek.

PLANE COORDINATE POSITION DATA

State _____ Zone _____
X _____
Y _____
Estab. By _____
Agency

Signature
Hambleton

Title _____ Division **ORLS** Headquarters **645**

Date **8-78** 7100-52-(3/68)

CORNER RECORD (PERPETUATION)

MONUMENT: DESCRIBE NEW MONUMENT SET, OR WORK DONE TO PRESERVE EXISTING MONUMENT

Set a 2 1/2" x 30" iron pipe w/brass cap mkd.:
Large mound of stone around monument.

T 5 S
N-1/16
S 16 | S 15
R 34 E
1978
ORLS 645

9

ACCESSORIES: DESCRIBE NEW BT'S WITNESS OBJECTS ETC. ESTABLISHED, OR WORK DONE TO PRESERVE EXISTING EVIDENCE

6" pine bears N 60 E, 36.67 ft. scribed 1/16S S15 BT.
6" pine bears S 45 W, 46.67 ft. scribed 1/16S S 16 BT.
Painted blaze and band of BT's red & yellow. Tagged trees w/54-3&4 signs.
Set steel fence post by mound of stone w/signs 54-4, 6&9.

10

Work Done By J. Hambleton Title Surveyor Date 8-78 State Registration No. or Agency ORLS 645

Certified Cor. Record Prepared? Yes No Filed At Union CS Date _____

11

REMARKS

Witnesses: L. Green
L. Shirley

12

Index File No. / T. R. M. Tract or Surv. No. Cor. 13