

OREGON CORNER RESTORATION FORM

COUNTY: Umatilla DATE: 03/23/04

CORNER DESIGNATION: N-17, The Southwest Corner of Section 14, T6N, R33E, W.M.

PREVIOUS RENEWALS/SURVEYS ETC.: Corner originally established by Nicholas O. Walden, U.S. Deputy Surveyor, under Contract No. 209, dated July 6, 1874. Record states: Drove charred stake & raised mound of earth, with pits, etc., as per instructions, for Cor. to Secs. 14, 15, 22 & 23.

MONUMENT AND ACCESSORIES FOUND: None. After verification by survey, reestablished corner point a fence corner with old fences extending South and South 72° East. There is also a field line extending North 82° West from the corner point.

MONUMENT MARKING DETAIL:

T6N R33E
S15 | S14
S22 | S23
2004
PLS 1106

MONUMENT SET: At position as described, set a 2 1/2" brass cap (marked as shown in "Monument Marking Detail"), on a 1 1/4" x 30" galvanized iron pipe 28 " in the ground, just North of fence corner post.

New accessories to corner monument:

- A 5/8" x 30" iron rebar with yellow plastic cap marked "OR PLS 1106, WA PLS 17372", set with plastic cap 2" above ground level in fence line bears South, 14.4 feet.
 - A 5/8" x 30" iron rebar with yellow plastic cap marked "OR PLS 1106, WA PLS 17372", set with cap 2" above ground level in fence line bears South 38.9 feet.
 - A 5/8" x 30" iron rebar with yellow plastic cap marked "OR PLS 1106, WA PLS 17372", set with cap 2" above ground level in fence line bears S 71° E, 28.0 feet.
 - A 5/8" x 30" iron rebar with yellow plastic cap marked "OR PLS 1106, WA PLS 17372", set with cap 2" above ground level in fence line bears S 71° E, 56.7 feet.
- Attached bearing object signs to all rebar accessories and nailed witness sign to fence corner post South of new brass cap monument.



LOCATION AND COMMENTS: Corner is located at fence corner with fences extending South and South 72° East.

FIRM: William R. Wells, PLS
P.O. Box 1696
Pendleton, OR 97801

COMPASS DECLINATION: 18° East Surveyor's Seal

Witnesses: Jason Wells, LSIT
Mark Hammersla

\6N33N17

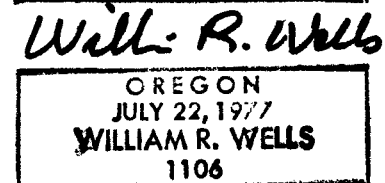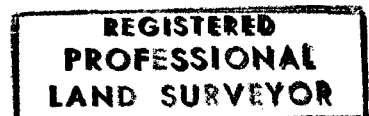

renews 6-30-04

RECEIVED BY
Umatilla County Surveyor
Date 4-04
Rec'd by KK
No. 04-73-B