

OREGON CORNER RESTORATION FORM

Section 26 Township 6N Range 33E
 County Umatilla Date: April 1, 2003

Corner Designation: 6N33T17

Condition Report Only
 Not found
 Remonumented
 Unrecorded
 Surveyed in
 Referenced out


Common quarter corner to sections 26 and 27, T6N, R33E, W.M., Umatilla County, Oregon.

Previous Renewals / Surveys, etc.


Corner originally set by Nicholas O. Walden under contract No. 209 dated July 6th, 1874. His record reads: Set basalt stone, 18 x 10 x 8, 9 ins. in ground for 1/4 Sec. Cor.

Monument and Accessories found: (condition and source)

I found the stone set by Walden firmly in place and marked 1/4 on the East face. Remains of a fence line ran North and East.

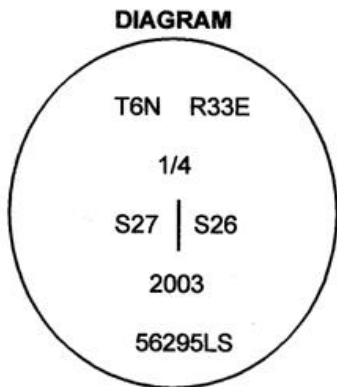

- ⊙ = Brass cap
- = Guard post
- = Iron rebar reference

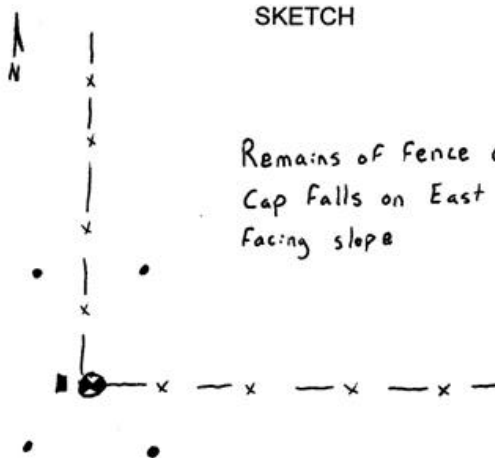

Remains of fence only.
 Cap falls on East
 Facing slope

MONUMENT (S) AND ACCESSORIES SET (Procedures and Description)

I set a 1 1/2" x 30" galvanized iron pipe with a 2 1/4" brass cap stamped as shown in the diagram above at the position of the stone. I set a 5" steel guard post with a County monument sign attached along side. I buried the stone at the side of the brass cap.

For references, I set four 5/8" by 24" green coated iron rebars with 1 1/8" orange plastic caps stamped WTS and 56295LS as described below:

- a rebar bears N46°04'27"E, 27.05' feet;
- a rebar bears N46°29'52"W, 28.81 feet;
- a rebar bears S43°37'07"W, 27.17 feet;
- a rebar bears S46°30'38"E, 30.16 feet;

The monument and references were tied using a LIECA system 300 RTK GPS.

Location and comments
 NAD 83-91 coordinates from a single
 GPS tie to tri station GEER.

N 845897.87
 E 8669165.50
RECEIVED BY:
Umatilla County Surveyor
 Date: 11-03
 Rec'd By: KE
 No. 03-315-C

Compass Declination
 Firm / Agency
 Witness Tree Surveying
 Address
 P.O. Box G
 Pilot Rock, Or. 97868
 Party Chief
 Stephen K, Haddock

Surveyors Seal

REGISTERED
 PROFESSIONAL
 LAND SURVEYOR

Stephen K. Haddock

OREGON
 JULY 9, 2001
 STEPHEN K. HADDOCK
 56295LS

RENEWAL DATE 6-30-05