

**OREGON CORNER RESTORATION FORM**

Section 30 Township 6N Range 34E  
 County Umatilla Date: December 11, 2002

Corner Designation: 6N34R3

Common quarter corner to sections 19 and 30, T6N, R34E, W.M., Umatilla County, Oregon.

State Plane Coordinates, Oregon North, 83(1991)  
 N = 847308.91 E = 8682244.76



Condition Report Only  
 Not found  
x Remonumented  
 Unrecorded  
 Surveyed in  
x Referenced out

**Previous Renewals / Surveys, etc.**

Corner originally set by Deputy Surveyors Odell & Lewis under contract 110 dated February 7, 1865. Their record reads: Set 1/4 Sec. post Cor. drove charred Stake, dug pits, raised mound as per instructions. Willard Bradley reestablished this corner in 1914 under survey Q-813-A. His record reads: 1/4 corner, established stone. Aubrey Perry indicates he used this corner in 1919 under the survey recorded in the Record of Private Surveys Book 2, Page 306.

**Monument and Accessories found: ( condition and source )**

A granite stone 6"x7"x4" with 5 notches on the East and 1 notch on the West, 6 inches below the surface at a fence corner with fences running West and Southeast and a power line running north.

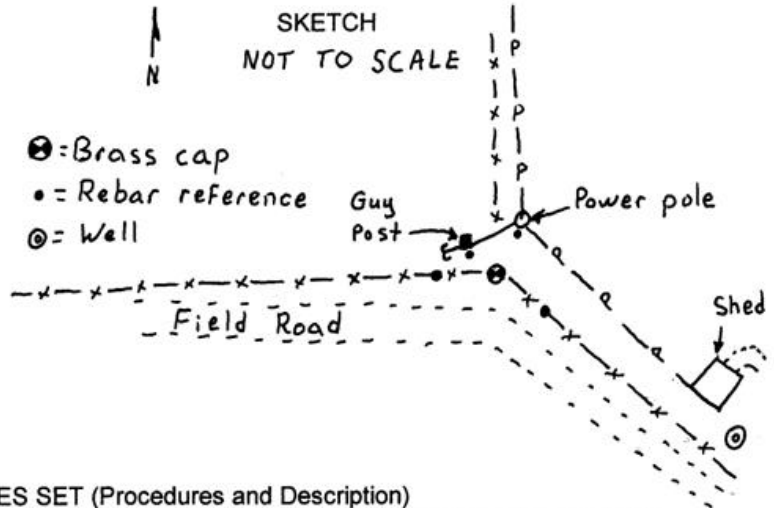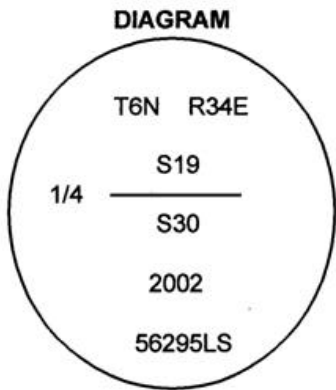

**MONUMENT (S) AND ACCESSORIES SET (Procedures and Description)**

I set a 2 1/4" brass cap on a 1 1/2" x 30" galvanized iron pipe 28" in the ground. I buried Bradley's stone at the foot of the monument on the East side. I attached a County monument sign to the fence corner post.

For references, I set four 5/8" by 24" green coated iron rebars with 1 1/8" orange plastic caps stamped WTS and 56295LS as described below:

- an iron rebar bears N35°25'56"E, 35.94 feet on the south side of a power pole;
- an iron rebar bears S44°50'21"E, 35.98 feet on the south side of the existing fence;
- an iron rebar bears S88°37'07"W, 22.43 feet on the south side of the existing fence;
- an iron rebar bears N49°19'39"W, 22.90 feet on the south side of a power line guy pole;

The monument and references were tied using a LIECA system 300 RTK GPS.

Location and comments

Compass Declination

Surveyors Seal

RECEIVED BY:  
Umatilla County Surveyor  
 Date: 2-03  
 Rec'd By: KK  
 No. 03-21-C

Firm / Agency  
 Witness Tree Surveying  
 Address  
 P.O. Box G  
 Pilot Rock, Or, 97868  
 Party Chief  
 Stephen K, Haddock

REGISTERED PROFESSIONAL LAND SURVEYOR  
*Stephen K. Haddock*  
 OREGON  
 JULY 9, 2001  
 STEPHEN K. HADDOCK  
 56295LS  
 RENEWAL DATE 6-30-03