

**OREGON CORNER RESTORATION FORM**

**Section:** 17 & 18  
**Township:** 6 North  
**Range:** 35 East of the Willamette Meridian  
**County:** Umatilla  
**Date:** June 1, 2002

**Corner Indexing Information:** Township 6N Range 35E Corner Code J-K 5 (Willamette Meridian)  
**Additional Identifier:** (e.g. BLM designation for the corner, street intersection, plat name, block, lot, etc.)

This corner is common to sections 17 & 18.

**Oregon Plane Coordinates:** N: 857477.660 E: 8716454.580

**Zone:** North **Order:** second **Datum:** NAD83-91 **Convergence:** 1°26'07.7" **Scale Factor:** .99996609


**Previous Renewals/Surveys, etc:** Originally surveyed by U.S. Deputy Surveyor William Odell under his contract No. 110, dated 8-23-1865. The Surveyor General's notes state, "set post corner for sections 17 and 18, drove charred stake, dug pits, and raised mounds as per instructions." Survey No. 54, Book 1, Page 257, Arnold set a smooth boulder 20"x9"x8" 16" in the ground at the surveyed position for closing corner for fractional sections 17 and 18. Walla Walla County Road Project 56-10, File 1, drawer 0-37, field book # 363, dated September 4, 1956, shows a found rock with an "x". Umatilla County Survey No. 9340-B, dated 5-26-93, Harris set a brass cap by survey. Umatilla County Survey No. 99-209-C, dated 10-08-99, Tomkins Land Survey set a 2 1/2" aluminum cap by survey per Walla Walla County records.

**Monument(s) & Accessories Found (Condition & Source):**

At the intersection of the West line of section 17, T6N 35E, with the Stateline. Found a 2 1/2" aluminum cap on a 2 1/2" aluminum pipe 1.6 feet below the surface of an alfalfa field.

**Monument Set (Procedures & Description):**

**Monument Detail:**

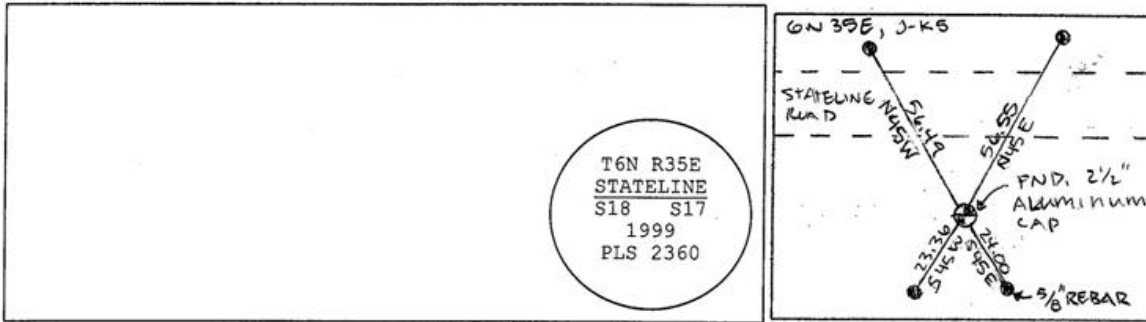

**New Accessories: WE SET:**

A 5/8 rebar with yellow plastic cap stamped 'Tomkins Surveying' which bears N 45°E ~ 56.55 feet from the corner. A 5/8 rebar with yellow plastic cap stamped 'Tomkins Surveying' which bears S 45°E ~ 24.00 feet from the corner. A 5/8 rebar with yellow plastic cap stamped 'Tomkins Surveying' which bears S 45°W ~ 23.36 feet from the corner. A 5/8 rebar with yellow plastic cap stamped 'Tomkins Surveying' which bears N 45°W ~ 56.49 feet from the corner.

**Location & Comments:**

**Compass Declination:**

19° East

**Surveyor's Seal**

**Firm/Agency:** Tomkins Land Surveying, Inc.  
 20 E. Poplar, Suite 204  
 Walla Walla, WA 99362

REGISTERED  
 PROFESSIONAL  
 LAND SURVEYOR

*Paul W. P. Tomkins*

OREGON  
 JULY 26, 1988  
 PAUL W. P. TOMKINS  
 2360

**Party Chief:** Bryan Martin  
**Notes:** Bryan Martin  
**Witness:** Eric Flowers

*renews 6/30/04  
 6/30/02*