

OREGON CORNER RESTORATION FORM

Section 19 Township 6N Range 35E
 County UMATILLA Date 4/10/03

CORNER DESIGNATION

R-5

- Condition Report Only
- Not Found
- Renewed
- Unrecorded
- Surveyed In
- Referenced Out

Previous Renewals/Surveys, etc.:


Odell and Lewis, under Contract No. 110, dated February 7, 1865, drove charred stake, dug pits, and raised mound. McLind found a bolt and held it for north-south position only, as its location east-west didn't match existing fence lines (Survey N-64-C). ODOT remonumented bolt with brass cap in 1995 (no record filed). Some recent surveys have held the brass cap.

Monument(s) & Accessories Found: (Condition and Source)

Found the ODOT brass cap. Its position was not held.

Monument Detail

Sketch
NOT TO SCALE

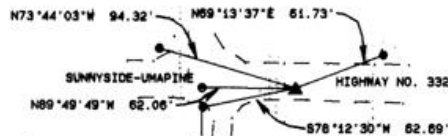

Monument Set (Procedures and Description):

Set railroad spike stamped "LS2627" with punch mark flush with the asphalt surface of Highway No. 332 at record distance per McLind's survey from the ODOT brass cap (previously a bolt) near the southeast corner of Section 19 and on line between it and the ODOT brass cap at the east 1/16th corner between Sections 20 and 29 (formerly a brass screw in lead plug).

- FOUND 3 1/2" BRASS CAP SET BY ODOT
- ▲ SET RAILROAD SPIKE STAMPED "LS2627" WITH PUNCH MARK
- SET 5/8" X 30" IRON REBAR WITH YELLOW PLASTIC CAP MARKED "UCPMD...LS2627"

New Accessories:

- A 5/8" iron rebar with yellow plastic cap marked "UCPMD...LS2627" bears N73°44'03" W, 94.32' (A wood fence post with bearing object tag bears 0.4' west from pin).
- A 5/8" iron rebar with yellow plastic cap marked "UCPMD...LS2627" bears N69°13'37" E, 61.73' (A PPGL pole with bearing object tag bears 0.9' northeast from pin).
- A 5/8" iron rebar with yellow plastic cap marked "UCPMD...LS2627" bears S78°12'30" W, 62.69' (A metal fence post with bearing object tag bears 0.6' southwest from pin).

Location and Comments: Compass Declination: N/A Surveyor's Seal

From the 4-way intersection of Highway 332, Umapine Road, and Ringer Road in Umapine, travel approximately 1 mile east on Highway 332 to the corner, which is a railroad spike set flush with the asphalt in the south travel lane of the highway.

Firm/Agency:
Umatilla County
Road Department

Address:
3920 Westgate
Pendleton, Oregon 97801

Party Chief:
Gary Roberts
Notes:
Gary Roberts
Witness:
None

REGISTERED
PROFESSIONAL
LAND SURVEYOR

Gary R. Roberts
OREGON
JULY 20, 1993
GARY R. ROBERTS
2627

RENEWS 12/31/2004

RECEIVED BY

Umatilla County Surveyor

Date 4-03

Rec'd By KK

No. 03-59-B

OREGON STATE PLANE COORDINATES
NAD '83 (91) NORTH ZONE 3601 (INTERNATIONAL FEET)

NORTHING: 848,571.70
EASTING: 8,716,692.86