

# OREGON CORNER RESTORATION FORM

COUNTY: Umatilla      DATE: 11/05/2014

**CORNER DESIGNATION:** L-17, Quarter Corner Section for Sections 14 and 15, Township 6 North, Range 37E, W.M.

**PREVIOUS RENEWALS/SURVEYS ETC:**

Originally surveyed by A.H. Simmons for Deputy Surveyor George Williams under his contract No. 176 dated October 23, 1872; his notes state "Set stake, mound and pits for ¼ sec. cor."

BLM Cadastral Surveyor C. Alfred White in his April 21, 1965 Survey for Group 572, Oregon, states in his notes: "Point for the ¼ sec. cor. of secs. 14 and 15, at proportionate distance; there is no remaining evidence of the original corner.  
No permanent monument established."

**MOUNUMENT AND ACCESSORIES FOUND:**

No evidence found.

**MOUNUMENT MARKING DETAIL:**

LS 02820  
S 15 | S 14  
T 6N | R 37E  
2014

**MOUNUMENT AND ACCESSORIES SET:**

At the surveyed position, set a 1½" x 30 galvanized iron pope with a 2½" brass cap protruding 9" above ground, from which:

A 5/8" x 30" iron rebar, with yellow plastic cap marked "TLS-HDJ" bears N. 34° W., 11.00' dist.

A White fir, 18" in diam., bears N. 40° E., 18.50' dist.

A 5/8" x 30" iron rebar, with yellow plastic cap marked "TLS-HDJ" bears S. 71° E., 10.00' dist.

A 5/8" x 30" iron rebar, with yellow plastic cap marked "TLS-HDJ" bears S. 74° W., 9.40' dist.

**LOCATION AND COMMENTS:**

Bearings taken with Silva hand compass and distances measured with a steel tape.

**OREGON STATE PLANE COORDINATE, North Zone, NAD 83(91), International Feet:**

N = 858769.48



E = 8795924.39

**COMPASS DECLINATION:** 15° East

**SURVEYORS' SEAL:**

**FIRM:** HDJ Design Group  
5 N. Colville, Suite 200  
Walla Walla WA 99362

**WITNESSES:** Felipe G. Hernandez  
Corey A. West

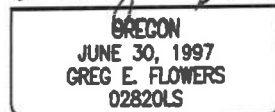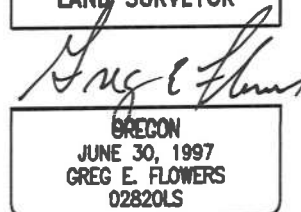

RENEWS 12/31/15  
06/29/2015

15-063-BC