

Index  
File No. N 14

**CORNER RECORD (SEARCH)**


(Ref. FSM 7151.4)

Tract or  
Survey No. \_\_\_\_\_ Cor.  
No. \_\_\_\_\_

T 6N R. 38E R.D. Walla Walla County Umatilla

Merid. Willamette N.F. Umatilla State Oregon

**CORNER DIAGRAM**

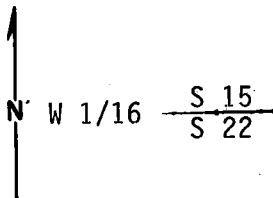

**DESCRIBE CORNER MONUMENT FOUND**

Found 3" B.L.M. brass cap with a few stones at base. Stamped † set in 1991.

**DESCRIBE BEARING TREES OR OTHER OFFICIAL ACCESSORIES FOUND**

- 1) Found 20" scribed Fir with 54-3 sign which reads T6N R38E Sec. 22 N 66 E 65½ lks. RJ 7/91
- 2) Found 12" scribed Fir with 54-3 sign which reads T6N R38E Sec. 15 S 35 W 141½ lks. RJ 7/91

**PHOTO IDENTIFICATION DATA**

Photo No. \_\_\_\_\_  
Filed At. \_\_\_\_\_  
Object Ident. \_\_\_\_\_  
Ident. By \_\_\_\_\_  
*Signature*

**DESCRIBE CORNER LOCATION RELATIVE TO NEAR-BY FEATURES, ALSO HOW TO REACH CORNER**

Head east on Mill Creek Road to gate at end. Head north 1000' up draw. Corner lies 150' up west side.

**PLANE COORDINATE POSITION DATA**

State \_\_\_\_\_ Zone \_\_\_\_\_  
X \_\_\_\_\_  
Y \_\_\_\_\_  
Estab. By \_\_\_\_\_  
*Agency*

Signature

Title

Division

Headquarters

Date

FS-7100-52 (3/68)

PAUL TOMKINS

PLS 2360

7/92

**CORNER RECORD (PERPETUATION)**

**MONUMENT: DESCRIBE NEW MONUMENT SET, OR WORK DONE TO PRESERVE EXISTING MONUMENT**

**ACCESSORIES : DESCRIBE NEW BT'S WITNESS OBJECTS ETC. ESTABLISHED, OR WORK DONE TO PRESERVE EXISTING EVIDENCE**

Work Done By \_\_\_\_\_ Title \_\_\_\_\_ Date \_\_\_\_\_ State Registration No. \_\_\_\_\_  
or Agency \_\_\_\_\_

Certified Cor. Record Prepared ? Yes ( No ) Filed At: \_\_\_\_\_ Date \_\_\_\_\_

**REMARKS**

Index File No. N 14 T. 6N R. 38E M. W.M. Tract or Surv. No. Cor.

USDA-FOREST SERVICE

Index  
File No. N-14

CORNER RECORD (SEARCH)

(Ref. FSM 7151.4)

Tract or  
Survey No. \_\_\_\_\_

Cor.  
No. \_\_\_\_\_

T 6N R. 38E


R.D. WALLA WALLA County UMATILLA

Merid. WILLAMETTE

N.F. UMATILLA

State OR

CORNER DIAGRAM

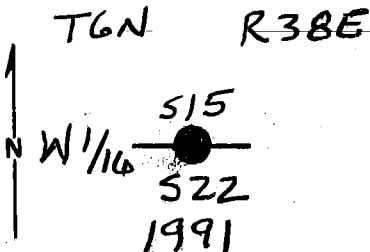

DESCRIBE CORNER MONUMENT FOUND

BRASS CAPPED STEEL PIPE SET BY SURVEY BY BLM.

DESCRIBE BEARING TREES OR OTHER OFFICIAL ACCESSORIES FOUND

PHOTO IDENTIFICATION DATA

Photo No. \_\_\_\_\_

Filed At. \_\_\_\_\_

Object Ident. \_\_\_\_\_

Ident. By \_\_\_\_\_

*Signature*

PLANE COORDINATE POSITION DATA

State \_\_\_\_\_ Zone \_\_\_\_\_

X \_\_\_\_\_

Y \_\_\_\_\_

Estab. By \_\_\_\_\_

*Agency*

Signature

Title

Division

Headquarters

Date

1991

FS-7100-52 (3/68)

**CORNER RECORD (PERPETUATION)**

**MONUMENT: DESCRIBE NEW MONUMENT SET, OR WORK DONE TO PRESERVE EXISTING MONUMENT**

**ACCESSORIES : DESCRIBE NEW BT's WITNESS OBJECTS ETC. ESTABLISHED, OR WORK DONE TO PRESERVE EXISTING EVIDENCE**

Work Done By: \_\_\_\_\_ Title: \_\_\_\_\_ Date: \_\_\_\_\_ State Registration No. \_\_\_\_\_  
or Agency: \_\_\_\_\_

Certified Cor. Record Prepared ? Yes No Filed At: \_\_\_\_\_ Date: \_\_\_\_\_

**REMARKS**

Index File No. T. R. M. Tract or Surv. No. Cor.