


CERTIFIED RECORD OF LAND CORNER MONUMENTATION

History of original corner establishment:

See the attached Affidavit. Adjoining landowners set and used an iron pin to identify their property line in or about the year 1901.

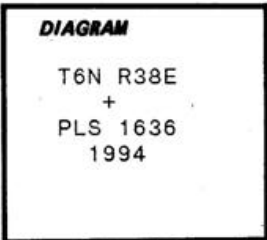

Description of corner evidence found:

A dilligent search, using a metal detector, did not reveal the original iron pin.

Description of monument and accessories I established to perpetuate the original location of this corner:

At the point identified by Mr. Robert A. Klicker as the point occupied by the iron pin, I set a 5/8" x 24" iron rod 10" into bedrock. The iron rod has a 1 1/2" aluminum cap attached which is marked "T6N R38E PLS 1636 1994". This cap is protruding 8" above the surface of the ground. I also placed a 2 1/2" x 30" aluminum pipe with a 3 1/4" aluminum cap attached directly over the iron rod. This pipe is set 6" into the ground and is surrounded with a mound of stones. The cap is marked as shown in the diagram above.

I hereby certify the corner point identified by Mr. Robert Allen Klicker was perpetuated as hereon described on May 5, 1994.


Dennis L. Gaylord
 OREGON
 JULY 14, 1978
 DENNIS L. GAYLORD
 1636
 RENEWS 6-30-1995

Office of COUNTY SURVEYOR County of UMATILLA
 State of OREGON, I hereby certify that the within instrument was filed in this office
 for record on the..... day of....., 19.....
 by
 (COUNTY OFFICIAL) (DEPUTY)

Form R6-7100-57 (9/71)

RECEIVED BY
 Umatilla County Surveyor
 Date 6-94
 Rec'd By KK
 No. 94-66-R

AFFIDAVIT

This affidavit is in general reference to Township 6 North, of Range 38 East of the Willamette Meridian, and specifically to the East-West Center Line of Section 20 therein.

The original patentees (settlers) of this township, found the terrain steep, rugged and cut by deep canyons. More often than not, it was difficult or impossible to sight from one section corner to another. Compass bearings were unreliable, presumably because of local magnetic disturbances. W. H. Odell's map of the area showed Compass Variation from 19 to 24 degrees, in relation to true North Meridians. According to his certificate dated Sept. 1, 1873, (he was the Surveyor General of Oregon) the map was in strict conformance to the original survey field notes which had been examined, approved and filed in his office.

Early pioneers found survey corners which marked odd shaped sections (not being in alignment with one another). Some corners were located as much as several hundred yards from where they might be expected to be.

Consequently, early pioneers took and claimed their lands as marked by the corners on the ground, in spite of some difficulty identifying the location of the lines. There were remarkably few disputes between landowners. Sometimes, the precise location of lines separating adjoining parcels, was settled by informal agreement.

For many years there was an iron pins set on what appeared to be the Northeast Corner of the West Half of the Southwest Quarter of Section 20, in Township 6, North of Range 38, E.W.M. It was near the confluence of Webb Creek and Henry Creek, on what appeared to be the east-west centerline of Section 20. It was by the adjacent property owners taken and believed to be such corner, and was by them verbally and specifically acknowledged to be such corner.

To the best of my knowledge, this iron pin was in existence when in (or about the year) 1901 the adjacent landowners (Mina Garland Klicker and Frank Baker of Blue Mountain Flume Co.) acknowledged this as such corner. This iron pin was pointed out to me in approximately 1948 by Jake E. Klicker, my father. He fully explained the significance of the iron pin to me at that time.

The line passing through this iron pin, and projecting easterly of Henry Creek, has been recognized by all subsequent landowners. Over the years, improvements have been made on the land and timber has been managed based on the agreed property boundary. The most recent reliance of the location of this line being when Boise Cascade Corporation and the Klicker family (Jake and Delbert) blazed trees along the line prior to logging and logging road construction in 1971.

In recent years, the pin was removed by persons or parties unknown. Although the original iron pin is now gone, I am able to identify where it was set. It was set just above a large fir tree just south of an ancient logging access road and on the spur ridge between Webb and Henry Creeks. This location is on a blazed line. There is a tree with apparent blazes a few feet to the east of where the iron pin was set.

I have accompanied Dennis L. Gaylord, Professional Land Surveyor, to the location on two occasions. A thorough search was conducted by Mr. Gaylord and myself but the iron pin could not be found. On May 5, 1994, I accompanied Mr. Gaylord to the location and pointed out to him the position occupied by the iron pin. Mr. Gaylord perpetuated the point by setting a flared aluminum pipe, with a 3 1/4 inch diameter aluminum cap attached, over a 3/4 inch by 24 inch iron rod driven into the bedrock 14 inches, at the position formerly occupied by the iron pin.

I HEREBY SWEAR the above statement made by me on this date to be true and factual to, the best of my ability and knowledge.

Dated June 7, 1994.




State of Washington,)

) ss.

County of Walla Walla.)

On this day personally appeared before me Robert Allen Klicker, to me known to be the identical individual who executed the foregoing statement and acknowledged to me that he signed the same free and voluntarily.

Dated June 7, 1994.

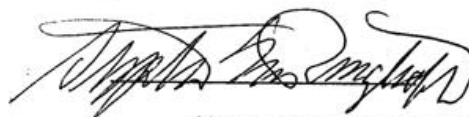

Notary Public In and For
The State of Washington,
Residing at Walla Walla.
My Commission Expires:
Aug. 15, 1995.