

USDA-FOREST SERVICE

Index
File No. V-25


CORNER RECORD (SEARCH)

(Ref. FSM 7151.4)

Tract or
Survey No. _____
Cor.
No. _____

T 6N R. 38E R.D. WALLA WALLA County UMATILLA
Merid. WILLAMETTE N.F. UMATILLA State OREGON

CORNER DIAGRAM

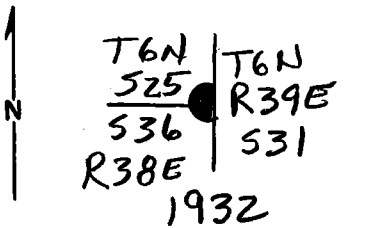

DESCRIBE CORNER MONUMENT FOUND

BRASS CAPPED IRON PIPE FOUND BY BLM

2

DESCRIBE BEARING TREES OR OTHER OFFICIAL ACCESSORIES FOUND

3

DESCRIBE CORNER LOCATION RELATIVE TO NEAR-BY FEATURES, ALSO HOW TO REACH CORNER

PHOTO IDENTIFICATION DATA

Photo No. _____
Filed At. _____
Object Ident. _____
Ident. By _____
Signature

6

7

PLANE COORDINATE POSITION DATA

State _____ Zone _____
X _____
Y _____
Estab. By _____
Agency

8

Signature

Title

Division

Headquarters

Date

1991

FS-7100-52 (3/68)

4

5

CORNER RECORD (PERPETUATION)

MONUMENT: DESCRIBE NEW MONUMENT-SET, OR WORK DONE TO PRESERVE EXISTING MONUMENT

ACCESSORIES : DESCRIBE NEW BT's WITNESS OBJECTS ETC. ESTABLISHED, OR WORK DONE TO PRESERVE EXISTING EVIDENCE

Work Done By _____ Title _____ Date _____ State Registration No. _____
or Agency _____
Certified Cor. Record Prepared ? Yes No Filed At: _____ Date _____

REMARKS

Index File No. T. R. M. Tract or Surv. No. Cor.

Index
File No. V-25

CORNER RECORD (SEARCH)

(Ref. FSM 7151.4)

Tract or
Survey No. _____

Cor.
No. 14 Sec. _____

T 6 N R. 38 E

R.D. Walla Walla County


Umatilla

Merid. WM

N.F. Umatilla State

Oregon

CORNER DIAGRAM

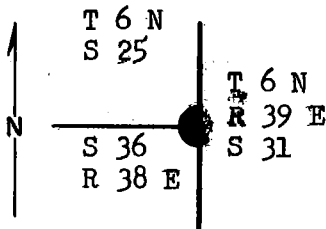

DESCRIBE CORNER MONUMENT FOUND

Iron pipe with brass cap.

DESCRIBE BEARING TREES OR OTHER OFFICIAL ACCESSORIES FOUND

48" Fir bears N 43° W, 47 ft. dist.
12" Fir bears S 80° W, 39 ft. dist.
Placed B.T. signs and marked each tree with paint.

PHOTO IDENTIFICATION DATA

Photo No. _____
Filed At. _____
Object Ident. _____
Ident. By _____
Signature

DESCRIBE CORNER LOCATION RELATIVE TO NEAR-BY FEATURES, ALSO HOW TO REACH CORNER

Corner lays on steep N.E. wooded slope, on the east edge of a well defined game trail, 20 ft. S. W. of ravine.
(OVER)

PLANE COORDINATE POSITION DATA

State _____ Zone _____
X _____
Y _____
Estab. By _____
Agency

Signature
D. B. Baker

Title
Engr. Tech.

Division
Engr.

Headquarters
Walla Walla

Date
9-4-63

7100-52 (3/68)

CORNER RECORD-(PERPETUATION)

1000 25

MONUMENT : DESCRIBE NEW MONUMENT SET, OR WORK DONE TO PRESERVE EXISTING MONUMENT

9

ACCESSORIES : DESCRIBE NEW BT'S WITNESS OBJECTS ETC., ESTABLISHED, OR WORK DONE TO PRESERVE EXISTING EVIDENCE

10

Work Done By _____ Title _____ Date _____ State Registration No. or Agency _____

Certified Cor. Record Prepared ? Yes No Filed At: _____ Date _____

11

REMARKS

THIS CORNER SHOULD BE APPROXIMATELY 20 FEET SOUTH OF THE CLOSING CORNER (BRASS CAP) OF SECTIONS 30 AND 31 T6N R39E, ACCORDING TO GLO NOTES OF A 1932 SURVEY.

(SEE T6N R39E V-1)

4-13-72 J.W. Blom

12

Index File No. V-25.T. R. M. Tract or Surv. No. Cor. 13