

USDA-FOREST SERVICE

Index
File No. V 5

CORNER RECORD (SEARCH)

(Ref. FSM 7151.4)

Tract or. _____
Survey No. _____
Cor. No. _____


T 6N R. 38E

R.D. Walla Walla County Umatilla

Merid. Willamette

N.F. Umatilla State Oregon

CORNER DIAGRAM

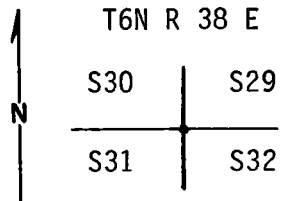

DESCRIBE CORNER MONUMENT FOUND

Found 3" BLM brass cap protruding 4" above ground. Stamped set 1991

2

DESCRIBE BEARING TREES OR OTHER OFFICIAL ACCESSORIES FOUND

- All trees tagged and scribed by RJ 1991
- 1) 14" Fir bears N 19° 15' E 34 lks from corner.
 - 2) 12" Fir bears N 65° 45' W 22lks from corner.
 - 3) 8" Fir bears S 59° W 14½ lks. from corner.
 - 4) 10" Fir bears S 20° E 6½ lks from corner.

6

PHOTO IDENTIFICATION DATA

Photo No. _____
Filed At. _____
Object Ident. _____
Ident. By _____
Signature _____

7

DESCRIBE CORNER LOCATION RELATIVE TO NEAR-BY FEATURES, ALSO HOW TO REACH CORNER

Proceed 1 3/4 miles up Henry Canyon Road from Mill Creek Road. Follow stream heading east then south for 2000'. Corner lies 200' up east side.

3

PLANE COORDINATE POSITION DATA

State _____ Zone _____
X _____
Y _____
Estab. By _____
Agency _____

8

Signature

Title

Division

Headquarters

Date

FS-7100-52 (3/68)

PAUL TOMKINS

PLS 2360

7/92

4

5

CORNER RECORD (PERPETUATION)

MONUMENT: DESCRIBE NEW MONUMENT SET, OR WORK DONE TO PRESERVE EXISTING MONUMENT

ACCESSORIES : DESCRIBE NEW BT's WITNESS OBJECTS ETC. ESTABLISHED, OR WORK DONE TO PRESERVE EXISTING EVIDENCE

Work Done By _____ **Title** _____ **Date** _____ **State Registration No.**
or Agency _____

Certified Cor. Record Prepared ? Yes (No) **Filed At:** _____ **Date** _____

REMARKS

Index File No. V5 **T.** 6N **R.** 38E **M.** W.M. **Tract or Surv. No.** _____ **Cor.** _____

USDA-FOREST SERVICE

Index File No. V-5

CORNER RECORD (SEARCH)


(Ref. FSM 7151.4)

Tract or Survey No. _____ Cor. No. _____

T 6N R. 38E R.D. WALLA WALLA County UMATILLA

Merid. WILLAMETTE N.F. UMATILLA State OREGON

CORNER DIAGRAM

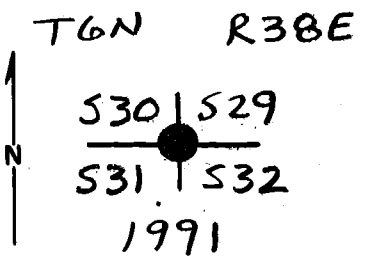

DESCRIBE CORNER MONUMENT FOUND

BRASS CAPPED STEEL PIN SET BY SURVEY BY BLM.

DESCRIBE BEARING TREES OR OTHER OFFICIAL ACCESSORIES FOUND

PHOTO IDENTIFICATION DATA

Photo No. _____

Filed At. _____

Object Ident. _____

Ident. By _____

Signature

DESCRIBE CORNER LOCATION RELATIVE TO NEAR-BY FEATURES, ALSO HOW TO REACH CORNER

PLANE COORDINATE POSITION DATA

State _____ Zone _____

X _____

Y _____

Estab. By _____

Agency

Signature

Title

Division

Headquarters

Date

1991

FS-7100-52 (3/68)

CORNER RECORD (PERPETUATION)

MONUMENT: DESCRIBE NEW MONUMENT SET, OR WORK DONE TO PRESERVE EXISTING MONUMENT

9

ACCESSORIES : DESCRIBE NEW BT's WITNESS OBJECTS ETC. ESTABLISHED, OR WORK DONE TO PRESERVE EXISTING EVIDENCE

10

Work Done By. _____ **Title** _____ **Date** _____ **State Registration No.**
or Agency _____

Certified Cor. Record Prepared ? Yes No **Filed At:** _____ **Date** _____

11

REMARKS

Index File No. T. R. M. **Tract or Surv. No.** Cor. _____

12

13