


**HISTORY OF ORIGINAL CORNER ESTABLISHMENT:**

This record has been prepared to provide current information regarding the condition of the corner monument and accessories as described in the survey records cited below. Verification of the position of the corner monument and dimensions to existing accessories, and the establishment of new corner accessories was not performed as part of this visit.

The source of the monumentation and dimensions cited in this record is a Dependent Resurvey of ...Portions of the South and East Boundary, and Subdivisional Lines of Township 6 North, Range 38 East, Willamette Meridian, conducted by the Bureau of Land Management, commenced on October 13, 1987, and completed September 16, 1991.

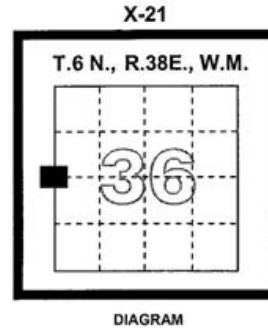

**RECORD DESCRIPTION OF CORNER MONUMENT AND ACCESSORIES:**

From the BLM Dependent Resurvey:

Point for the 1/4 sec. Cor. of secs. 35 and 36, at proportionate distance, there is no remaining evidence of the original corner. Set a stainless steel post, 28 ins. long, 2 1/2 ins. diam., 20 ins. in the ground, in collar of stone, with brass cap mkd. (See diagram below), from which:

A fir, 30 ins. diam., bears N15 1/4°E 79 lks. dist., mkd. 1/4 S36 BT,

A spruce, 42 ins. diam., bears S83 1/2°W 51 1/2 lks. dist., mkd. 1/4 S35 BT,

Deposit a white "DEEP-1" magnetic marker at base of stainless steel post. The corner is located on steep NE slope in timber and dense undergrowth.


**DESCRIPTION OF MONUMENT AND ACCESSORIES FOUND AT THIS CORNER LOCATION:**

**Found:**

A 3" brass cap, marked as shown, on 2 1/2" stainless steel pipe, firmly set in small mound of stone, extending 6" above ground, on a steep NE slope and in an alder thicket, from which:

A 36" Grand Fir, alive and in good condition, with partial scribing visible on nearly healed single blaze (BLM 1991 NE bearing tree)

A 42" Engelmann Spruce, standing dead, with scribing "1/4 S35 BT" visible on an unhealed single blaze (BLM 1991 SW bearing tree)

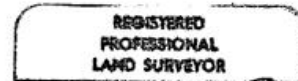

*renews 12/31/06*

I hereby certify that the above corner position was visited and found as described on October 18, 2005.

Witnesses: Tim Johnson, Gary Langlitz, Tom Duckworth

RECEIVED BY  
 Umatilla County Surveyor  
 Date 1-06  
 Rec'd by KE  
 No. 06-11-R