


LAND CORNER RECORD

5680-2

1. T. 6S R. 29E No. G-25 Cor. 1/4 Mer. W. State Oregon (Rectangular) N. F. Umatilla Dist. Ukiah 14

2. Corner Status

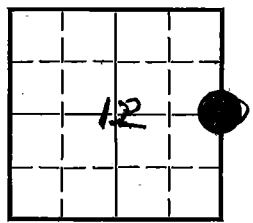

3. Original Description _____ Vol. _____ Page 111 Where Recorded _____

4. Description of Corners: Corner is a post from which:
 a 8" Pine Brs. N. 41° E. 19 lks.
 a 8" Pine Brs. S. 68° W. 26 lks.
 ● See mon. file, Brass Cap.

7. Photo Identification

Photo No. EBI 7-53
 Ident. By: KRJ

8. Plane Coordinate Position Data

State _____ Zone _____
 X _____
 Y _____
 Estab. By _____
 Field Book No. _____
 Where Filed _____

9. Evaluation

Authentic _____
 Needs Verif. _____ Monument No
 Re-estab. X Survey _____
 Land Status Public Domain

5. Investigation Notes: Corner post gone, temporary stake placed on possible corner.
 15" Western larch, dead, still usable scribing, tree standing. (Sec. 7 B.T.), placed red ring around tree.
 Sec. 12 B.T. gone, no evidence of its existence. FSRM to reference bearing tree; $4\frac{1}{2}$ " White fir bears S. 47° E., 5 lks. to B.T.
 FSRM to reference bearing tree; $6\frac{1}{2}$ " White fir bears N. 2° E., 11.8 lks. distance to B.T.
 Surveyor made mistake in B.T. species, Larch has definite scribing.

6. Signed Kenneth R. Johnson Forester Date June 2, 1965

PERPETUATION RECORD

10. Monument:

11. Accessories

Field Book _____ Page _____

12. Set By _____ Title _____
License _____ Agency _____ Date _____

13. Recorded By _____ Volume _____ Page _____
(Agency)
(Date) (City) (County) (State)

14. Remarks:

Index
File No. G-1

CORNER RECORD (SEARCH)
(Ref. FSM 7151.4)

Tract or
Survey No. _____ Cor. No. G-1


T 6S R. 30E

R.D. UK19h County Morrow-Umatilla Co., Ore

Merid. W11

N.F. Umatilla State Oregon

CORNER DIAGRAM

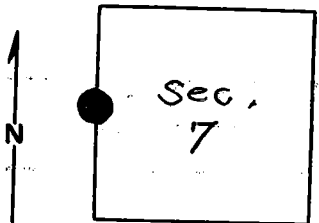

DESCRIBE CORNER MONUMENT FOUND

Brass cap monument.
Sec G-25, T6S, R29E, monumentation file.

DESCRIBE BEARING TREES OR OTHER OFFICIAL ACCESSORIES FOUND

6

PHOTO IDENTIFICATION DATA

Photo No. _____
Filed At. _____
Object Ident. _____
Ident. By _____

Signature

7

DESCRIBE CORNER LOCATION RELATIVE TO NEAR-BY FEATURES, ALSO HOW TO REACH CORNER

PLANE COORDINATE POSITION DATA

State _____ Zone _____
X _____
Y _____
Estab. By _____

Agency

8

Signature

J. Hollaman

Title

Division

Headquarters

Date

1/75

7100-52-(3/68)

5

CORNER RECORD (PERPETUATION)

MONUMENT : DESCRIBE NEW MONUMENT SET, OR WORK DONE TO PRESERVE EXISTING MONUMENT

ACCESSORIES : DESCRIBE NEW BT's WITNESS OBJECTS ETC. ESTABLISHED, OR WORK DONE TO PRESERVE EXISTING EVIDENCE

Work Done By _____ Title _____ Date _____ State Registration No. _____
or Agency _____
Certified Cor. Record Prepared ? Yes No Filed At _____ Date _____

REMARKS

Index File No. T. R. M. Tract or Surv. No. Cor.