

Index
 File No. R-25
 T 6S R. 29E
 Merid. WM


CORNER RECORD (SEARCH)
 (Ref. FSM 7151.4)

Tract or Survey No. _____
 Cor. No. R-25

R.D. UKIAH County MORROW
 N.F. UMATILLA State OREGON

CORNER DIAGRAM

DESCRIBE CORNER MONUMENT FOUND

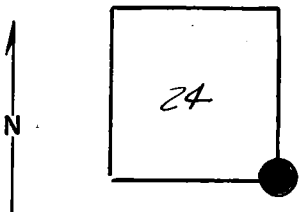

NONE

DESCRIBE BEARING TREES OR OTHER OFFICIAL ACCESSORIES FOUND

NONE

PHOTO IDENTIFICATION DATA

Photo No. _____
 Filed At. _____
 Object Ident. _____
 Ident. By _____
Signature

DESCRIBE CORNER LOCATION RELATIVE TO NEAR-BY FEATURES, ALSO HOW TO REACH CORNER

PLANE COORDINATE POSITION DATA

State _____ Zone _____
 X _____
 Y _____
 Estab. By _____
Agency

Signature D.J. Griffith Title PLSG44 Division _____ Headquarters _____ Date 12/75 7100-52 (3/68)

Ⓟ

CORNER RECORD (PERPETUATION)

MONUMENT: DESCRIBE NEW MONUMENT SET, OR WORK DONE TO PRESERVE EXISTING MONUMENT

AT PROPORTIONATE DIST. SET 2X"X30" IRON PIPE WITH BRASS CAP.

ACCESSORIES : DESCRIBE NEW BT'S WITNESS OBJECTS ETC. ESTABLISHED, OR WORK DONE TO PRESERVE EXISTING EVIDENCE

NEW BTS

A 2 1/2" JUNIPER N27E, 124.8 FT

A 1 1/2" PINE S14E, 106.4 "

A 1 1/2" JUNIPER S76W, 73.3 "

A 1 1/2" JUNIPER N45W 94.7 "

Work Done By D.I. GRIFFITH Title SURVEYOR Date _____ State Registration No. ORE PLS 694
or Agency _____

Certified Cor. Record Prepared ? Yes No _____ Filed At: MORROW CO. CT. HO. Date 12/75

REMARKS

SEE MAP OF SURVEY DATED DEC. 1975


Index File No. R-25 T. 6S R. 29E W.M. Tract or Surv. No. Cor. R-25

LAND CORNER RECORD

5680-2

1. T. 6S R. 30E No. R-1 Cor. Sec. Mer. W State Oregon (Rectangular) N. F. Umatilla C.R. Ukiah Dist. 9

2. Corner Status

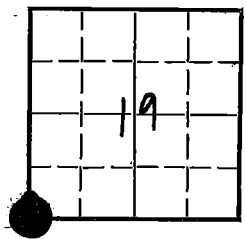

3. Original Description _____ Vol. _____ Page _____ Where Recorded _____

4. Description of Corners:

Ref: T. 6 S., R. 29 E., R-25

Brass Cap: see Monumentation File;

5. Investigation Notes:

7. Photo Identification

Photo No. _____

Ident. By: _____

8. Plane Coordinate Position Data

State _____ Zone _____

X _____

Y _____

Estab. By _____

Field Book No. _____

Where Filed _____

9. Evaluation

Authentic _____

Needs Verif. _____ Monument _____

Re-estab. _____ Survey _____

Land Status _____

6. Signed _____ Title _____ Date _____

PERPETUATION RECORD

10. Monument:

11. Accessories

Field Book _____ Page _____

12. Set By _____ Title _____

13. Recorded By _____ Volume _____ Page _____

(Agency)

License _____ Agency _____ Date _____

(Date) _____ (City) _____ (County) _____ (State) _____

14. Remarks:

R-1