

USDA-FOREST SERVICE

Index
File No. B-17

CORNER RECORD (SEARCH)


(Ref. FSM 7151.4)

Treaty or
Survey No. _____ Cor.
No. _____

T 6S. R. 30E. R.D. Ukiah County Umatilla

Merid. Willamette N.F. Umatilla State Oregon

CORNER DIAGRAM

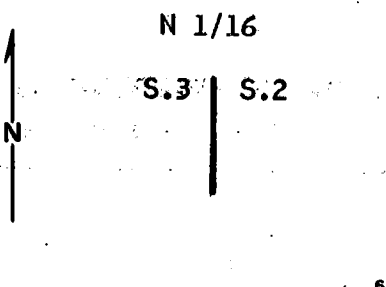

DESCRIBE CORNER MONUMENT FOUND

None

Set brass cap

DESCRIBE BEARING TREES OR OTHER OFFICIAL ACCESSORIES FOUND

None

PHOTO IDENTIFICATION DATA

Photo No. _____
Filed At. _____
Object Ident. _____
Ident. By _____
Signature

DESCRIBE CORNER LOCATION RELATIVE TO NEAR-BY FEATURES, ALSO HOW TO REACH CORNER

Go East from the intersection of U.S. Forest Road 419N and 537N, on 537N 2.5 miles. Corner is 400 ft. North of road.

PLANE COORDINATE POSITION DATA

State _____ Zone _____
X _____
Y _____
Estab. By _____
Agency

Signature
David H. Kline

Title _____ Division OPLS Headquarters 933 Date 7-77
7100-52-(3/68)

