

USDA-FOREST SERVICE

Index
File No. C-17

CORNER RECORD (SEARCH)

(Ref. FSM 7151.4)

Tract or
Survey No. _____ Cor.
No. _____


T 6S. R. 30E.

R.D. Ukiah County Umatilla

Merid. Willamette

N.F. Umatilla State Oregon

CORNER DIAGRAM

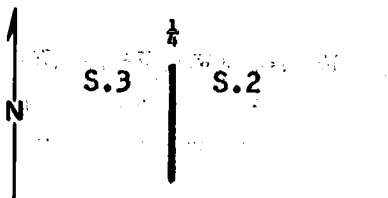

DESCRIBE CORNER MONUMENT FOUND

Mound of stone.
Set brass cap

DESCRIBE BEARING TREES OR OTHER OFFICIAL ACCESSORIES FOUND

14" pine N. 86°18' E. 14.6 ft.

PHOTO IDENTIFICATION DATA

Photo No. _____
Filed At. _____
Object Ident. _____
Ident. By _____
Signature

PLANE COORDINATE POSITION DATA

State _____ Zone _____
X _____
Y _____
Estab. By _____
Agency

DESCRIBE CORNER LOCATION RELATIVE TO NEAR-BY FEATURES, ALSO HOW TO REACH CORNER

From the intersection of U. S. Forest Road 419N and 537N, go East on 537N 3 miles. Corner is West of road about 700ft.

Signature
David H. Keller

Title Survey Division Headquarters OPLS 933

Date 7-77

7100-52-(3/68)

CORNER RECORD (PERPETUATION)

MONUMENT: DESCRIBE NEW MONUMENT SET, OR WORK DONE TO PRESERVE EXISTING MONUMENT

T. 6S., R. 30E.

Set 2½" x 30" iron pipe with brass cap.

‡

Pipe is 20" in ground.

S.3 S.2

Raised mound of stone around brass cap.

1977

Stamped:

PLS 933

9

ACCESSORIES: DESCRIBE NEW BT'S WITNESS OBJECTS ETC. ESTABLISHED, OR WORK DONE TO PRESERVE EXISTING EVIDENCE

A 6" pine bears N. 70°45'W. 28.4 ft.

Set steel post 4 ft. West of corner w/sign.

Painted red band around BT tree w/sign.

10

Work Done By. T. Hamby Title Party Chief Date 6/23/77 State Registration No. or Agency _____

Certified Cor. Record Prepared? Yes No _____ Filed At: _____ Date _____ 11

REMARKS

12

Index File No. T. R. M. Tract or Surv. No. Cor. 13