


CERTIFIED RECORD OF LAND CORNER MONUMENTATION

History of original corner establishment:

Unsurveyed - subdivided section

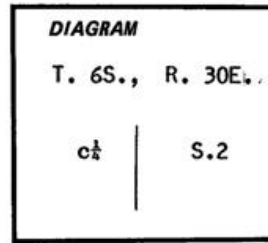

No record of subsequent remonumentation found in County Records.

Description of corner evidence found:

None.


Description of monument and accessories I established to perpetuate the original location of this corner:

Set 2 1/2" x 30" iron pipe 25" in ground with a brass cap marked as shown: From which I scribed Bearing Trees.

A 14" fir bears N. 80° W. 32.3 ft. mkd. c 1/4 S.2 T. 6S, R. 30E. BT.

A 8" fir bears S. 70° 50' E. 19.5 ft. mkd. c 1/4 S.2 T. 6S, R. 30E. BT.

Nailed a brass washer mkd. PLS 933 to BT blaze on both trees. Set steel fence post 32 ft. North of corner. Corner is 500.00 ft. North of old road. Used transit and steel tape, measuring to the center of BT.

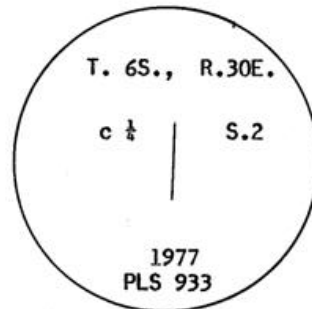

Office of.....County Surveyor..... County of.....Umatilla.....
 State of.....Oregon....., I hereby certify that the within instrument was filed in this office
 for record on the..... day of....., 19.....
David H. Krumbein by.....
 (COUNTY OFFICIAL) (DEPUTY)

C-19


m-64-B

CERTIFIED RECORD OF LAND CORNER MONUMENTATION

C-19

History of original corner establishment:

Unsurveyed - subdivided section

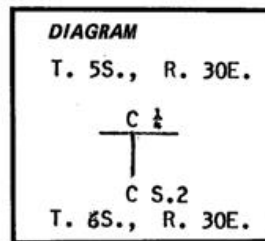

No record of subsequent remonumentation found in County Records.

Description of corner evidence found:

None.



Description of monument and accessories established to perpetuate the original location of this corner:

Set 2 1/2" x 30" iron pipe 22" in ground with a brass cap marked as shown. From which I scribed Bearing Trees.

A 14" pine bears S. 41°12'E. 55.7 ft. mkd. cc 1/2 S.2 BT.

A 9" fir bears S. 67°54'W. 47.4 ft. mkd. cc 1/2 S.2 BT.

Nailed a brass washer mkd. PLS 933 on the BT blaze on both trees. Set a steel post 4 ft. West of corner. Corner is 67 ft. South of a E-W fence line. Used transit and steel tape, measuring to the center of BTs.

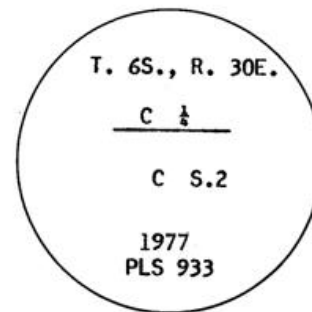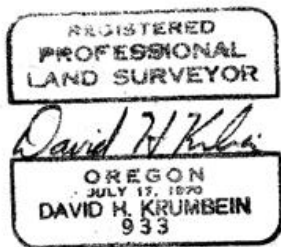

Office of.....County Surveyor..... County of.....Umatilla.....
 State of.....Oregon....., I hereby certify that the within instrument was filed in this office
 for record on the..... day of....., 19.....
David H. Krumbein by.....
 (COUNTY OFFICIAL) (DEPUTY)

C-19

m-64