


History of original corner establishment:

Unsurveyed - subdivided section

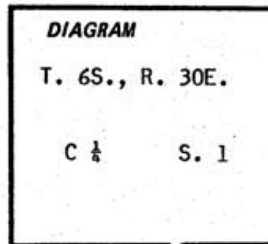

No record of subsequent remonumentation found in County Records.

Description of corner evidence found:

None.

Description of monument and accessories I established to perpetuate the original location of this corner:

Set 2½" x 30" iron pipe 20" in-ground with a brass cap marked as shown: From which I scribed Bearing Trees.

A 11" pine bears N. 27°29' E. 21.7 ft. mkd. C $\frac{1}{4}$ S. 1 BT.


A 12" pine bears S. 39°31' E. 22.9 ft. mkd. C $\frac{1}{4}$ S. 1 BT.

Nailed a brass washer mkd. PLS 933 to BT blaze of both trees. Set a steel post 2 ft. West of corner. Corner is 30 ft. South of E-W road. Raised mound of stone with a 3 ft. base within 4" of top of pipe. Used transit and steel tape, measuring to center of BT.

REGISTERED
PROFESSIONAL
LAND SURVEYOR

David H. Krumbein

OREGON
JULY 17, 1970
DAVID H. KRUMBEIN
933

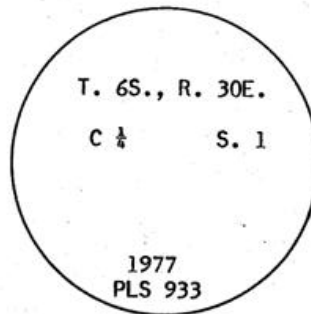

Office of.....County Surveyor..... County of.....Umatilla.....
 State of.....Oregon....., I hereby certify that the within instrument was filed in this office
 for record on the..... day of....., 19.....
David H. Krumbein by
 (COUNTY OFFICIAL) (DEPUTY)

C-23