


C-24

History of original corner establishment:

Unsurveyed - subdivided section

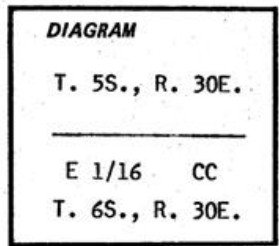

No record of subsequent remonumentation found in County Records.

Description of corner evidence found:

None.


Description of monument and accessories I established to perpetuate the original location of this corner:

Set 2 1/2" x 30" iron pipe 22" in ground with brass cap marked as shown: From which I scribed Bearing Trees.

A 12" pine bears N. 76°47' W. 18.6 ft. mkd. E. 1/16 CC S.1 BT.

A 9" pine bears S. 07°33' W. 19.5 ft. mkd. E. 1/16 CC S.1 BT.

Nailed a brass washer mkd. PLS 933 to the BT blaze on both trees. Set a steel fence post 3 ft. East of corner. Raised mound of stone to 2" of top of pipe. Used transit and steel tape, measuring to the center of BTs.

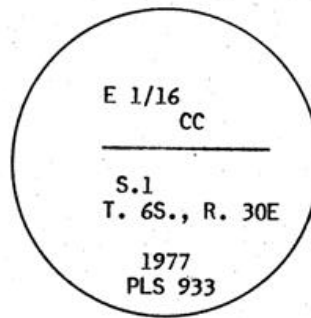

Office of.....County Surveyor..... County of.....Umatilla.....

State of.....Oregon....., I hereby certify that the within instrument was filed in this office for record on the..... day of....., 19.....

David H. Krumbein by.....
(COUNTY OFFICIAL) (DEPUTY)

C-24

77-64