

USDA-Forest Service

Index File No. C-25

T 65 R. 30E

Merid. WILLAMETTE

CORNER RECORD (SEARCH)

(Ref. FSM 7151.4)

R.D. UKIAH

N.F. UMATILLA


Tract or Survey No. \_\_\_\_\_

County UMATILLA

State OR

Cor. No. 1/4

CORNER DIAGRAM

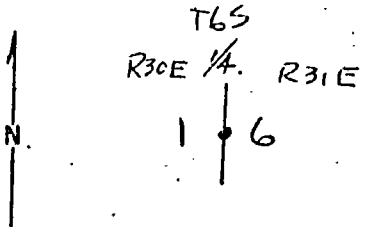

DESCRIBE CORNER MONUMENT FOUND

NONE

DESCRIBE BEARING TREES OR OTHER OFFICIAL ACCESSORIES FOUND

A 12" FIR STUMP BEARS N65°W 7.3 FT AXE MKS VISIBLE  
 A DEAD & DOWN 5" FIR BR. S65°E 130 FT MKD 1/4S BT  
 THIS TREE HAS SLID DOWN HILL

PHOTO IDENTIFICATION DATA

Photo No. \_\_\_\_\_  
 Filed At. \_\_\_\_\_  
 Object Ident. \_\_\_\_\_  
 Ident. By \_\_\_\_\_  
 Signature \_\_\_\_\_

PLANE COORDINATE POSITION DATA

State \_\_\_\_\_ Zone \_\_\_\_\_  
 X \_\_\_\_\_  
 Y \_\_\_\_\_  
 Estab. By \_\_\_\_\_  
 Agency \_\_\_\_\_

DESCRIBE CORNER LOCATION RELATIVE TO NEAR-BY FEATURES, ALSO HOW TO REACH CORNER

COR IS 55 FT. SOUTH OF DRY CREEK BED

Signature

Title

Division

Headquarters

Date


CORNER RECORD (PERPETUATION)

C-25 / C-1

GPO 802-478

MONUMENT. DESCRIBE NEW MONUMENT SET, OR WORK DONE TO PRESERVE EXISTING MONUMENT

SET 2 1/2" X 30" IRON PIPE MKD

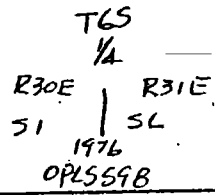

ACCESSORIES DESCRIBE NEW BT'S WITNESS OBJECTS ETC. ESTABLISHED, OR WORK DONE TO PRESERVE EXISTING EVIDENCE

NEW BT'S:

A 6" FIR BRG N41°E 28 1/2 FT. MKD T65 R31E 1/4 S6 BT.  
 A 10" FIR " S8°W 19 1/2 " " T65 R30E 1/4 S1 BT.

Work Done By R.D. Baggett Title LAND SURVEYOR Date 9-30-76 State Registration No. OPL5 598  
 or Agency

Certified Cor Record Prepared? Yes  No  Filed At CHATILLA C.S. Date

REMARKS

Index File No. 1 T. R. M. Tract or Surv. No. Cor.