


E-14

CERTIFIED RECORD OF LAND CORNER MONUMENTATION

History of original corner establishment:

Unsurveyed - subdivided section

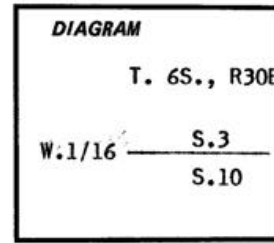

No record of subsequent remonumentation found in County Records.

Description of corner evidence found:

None.

Description of monument and accessories I established to perpetuate the original location of this corner:

Set 2½" x 30" iron pipe 16" in ground with brass cap marked as shown:
From which I scribed New Bearing Trees.


- A 10" pine bears N. 39°04' E. 38.5 ft. mkd. W.1/16 S.3 BT.
- A 10" pine bears S. 16°57' W. 31.5 ft. mkd. W.1/16 S.10 BT.

I nailed a brass washer mkd. "PLS 933" to the BT blaze of both trees. Set a steel post fence 3 ft. East of corner. Raised a mound of stone 3 ft. base within 2" of top of pipe. Used transit and steel tape, measuring to the center of new BTs. Corner is 320 ft. North of E-W road with yellow location tag.

REGISTERED
PROFESSIONAL
LAND SURVEYOR

David H. Krumbain

OREGON
JULY 17, 1970
DAVID H. KRUMBAIN
933

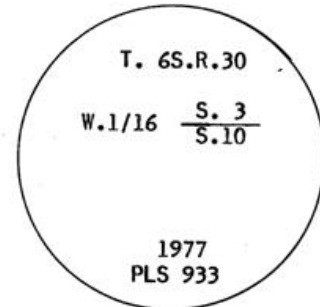

Office of.....County Surveyor..... County of.....Umatilla.....
State of.....Oregon..... I hereby certify that the within instrument was filed in this office
for record on the..... day of....., 19.....
David H. Krumbain by
(COUNTY OFFICIAL) (DEPUTY)

E-14

m-64