

USDA-FOREST SERVICE

Index
File No. E-24

CORNER RECORD (SEARCH)


(Ref. FSM 7151.4)

Tract or
Survey No. _____ Cor.
No. _____

T 6S. R. 30E. R.D. Ukiah County Umatilla

Merid. Willamette N.F. Umatilla State Oregon

CORNER DIAGRAM

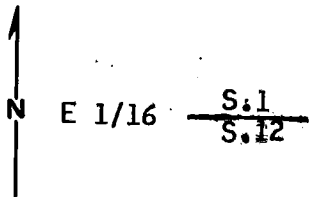

DESCRIBE CORNER MONUMENT FOUND

None

Set brass cap

DESCRIBE BEARING TREES OR OTHER OFFICIAL ACCESSORIES FOUND

None

PHOTO IDENTIFICATION DATA

Photo No. _____

Filed At. _____

Object Ident. _____

Ident. By _____

Signature

PLANE-COORDINATE POSITION DATA

State _____ Zone _____

X _____

Y _____

Estab. By _____

Agency

DESCRIBE CORNER LOCATION RELATIVE TO NEAR-BY FEATURES, ALSO HOW TO REACH CORNER

From the intersection of Oregon Highway 395 and Five Mile Creek, go up Five Mile Creek Road about 5.0 miles, then South-west about 0.6 miles and corner is South of road about 50 ft.

Signature
David H. Kula

Title

Division

Headquarters:

Date

OPLS

933

7-77

7100-52-(3/68)

CORNER RECORD (PERPETUATION)

MONUMENT: DESCRIBE NEW MONUMENT SET, OR WORK DONE TO PRESERVE EXISTING MONUMENT

T. 6S., R. 30E.

Set 2 1/2" x 30" iron pipe with brass cap.
Pipe is 10" in ground.
Mound of stone to cap.

E 1/16 $\frac{S.1}{S.12}$

1977
PLS 933

Stamped:

9

ACCESSORIES : DESCRIBE NEW BT'S WITNESS OBJECTS ETC. ESTABLISHED, OR WORK DONE TO PRESERVE EXISTING EVIDENCE

A 14" pine bears N. 05°40' E. 80.4 ft.
A 12" pine bears S. 70°37' E. 67.0 ft.

Set steel fence post 2 ft. North of corner w/sign.
Painted red band around bearing trees w/sign.

10

Work Done By T. Hamby Title Party Chief Date 6/23/77 State Registration No. or Agency

Certified Cor. Record Prepared ? Yes No Filed At: _____ Date _____

11

REMARKS

12

Index File No. T. R. M. Tract or Surv. No. Cor.

13