

USDA-FOREST SERVICE

Index File No. J-25


CORNER RECORD (SEARCH)

(Ref. FSM 7151.4)

Tract or Survey No. _____ No. _____

T 6S R. 30E R.D. UKIAH County UMATILLA
 Merid. WILLIAMETTE N.F. UMATILLA State OREGON

CORNER DIAGRAM

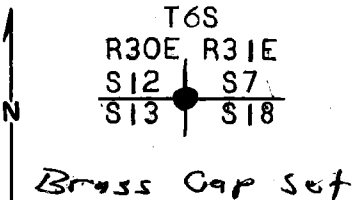

DESCRIBE CORNER MONUMENT FOUND

NONE

2

DESCRIBE BEARING TREES OR OTHER OFFICIAL ACCESSORIES FOUND

NONE

3

PHOTO IDENTIFICATION DATA

Photo No. _____
 Filed At. _____
 Object Ident. _____
 Ident. By _____
 Signature _____

DESCRIBE CORNER LOCATION RELATIVE TO NEAR-BY FEATURES, ALSO HOW TO REACH CORNER

CORNER IS ON ROCK HILLSIDE APX 150' SOUTH OF E-W FENCE. A LOCATION TAG IS ON FENCE AND ON ROAD NEAR CENTER S12.

PLANE COORDINATE POSITION DATA

State _____ Zone _____
 X _____
 Y _____
 Estab. By _____
 Agency _____

4

Signature Wayne O'Hain Title Co. Surveyor Division _____ Headquarters _____ Date _____ 7100-52-(3/68)

5

CORNER RECORD (PERPETUATION)

MONUMENT: DESCRIBE NEW MONUMENT SET, OR WORK DONE TO PRESERVE EXISTING MONUMENT

SET 3" x 30" IRON PIPE WITH BRASS CAP MARKED:

T6S
 R30E R31E
 S12 S7
 S13 S18
 1978 PLS 346

ACCESSORIES : DESCRIBE NEW BT'S WITNESS OBJECTS ETC. ESTABLISHED, OR WORK DONE TO PRESERVE EXISTING EVIDENCE

24" PINE S72 W 136.5' MKD T6S R30E S13 BT

22" PINE N51W 101.0 MKD T6S R30E S12 BT

24" PINE N77E 74.5 MKD T6S R30E S7 BT

22" PINE (FORKED) S29E 77.3 MKD T6S R31E S18 BT

BOTH BT'S HAVE A RED PAINTED STRIPE, BT AND ATTENTION SIGNS, AND
 A BRASS WASHER STAMPED PLS 346 NAILED TO LOWER BLAZE.

Work Done By W.O. HARRIS Title _____ Date 10-12-78 State Registration No. _____
 of Agency PLS 346

Certified Cor. Record Prepared ? Yes No Filed At: _____ Date _____

REMARKS

Index File No.

T.

R.

M.

Tract or Surv. No.

Cor.

12

13