

USDA-FOREST SERVICE

Index File No. N-19

CORNER RECORD (SEARCH)


(Ref. FSM 7151.4)

Tract or Survey No. _____ No. _____

T 6S R. 30E
Merid. WILLAMETTE

R.D. UKIAH County UMATILLA
N.F. UMATILLA State OREGON

CORNER DIAGRAM

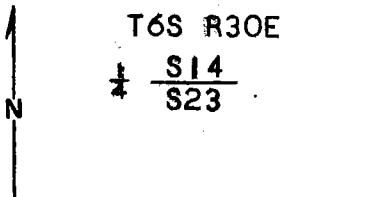

DESCRIBE CORNER MONUMENT FOUND

NONE

DESCRIBE BEARING TREES OR OTHER OFFICIAL ACCESSORIES FOUND

30" PINE S19W 89.9' SCRIBING VISIBLE
40" PINE STUMP N15E 67.8' NO SCRIBING, FITS BEARING AND DISTANCE, HAS POSSIBLE REVERSE SCRIBING ON BARK NEAR STUMP.

PHOTO IDENTIFICATION DATA

Photo No. _____
Filed At. _____
Object Ident. _____
Ident. By _____
Signature

DESCRIBE CORNER LOCATION RELATIVE TO NEAR-BY FEATURES, ALSO HOW TO REACH CORNER

THERE IS A LOCATION TAG APX. 500' SOUTH OF CORNER ON OLD ROAD.

PLANE COORDINATE POSITION DATA

State _____ Zone _____
X _____
Y _____
Estab. By _____
Agency

H.O. Davis Signature

Title _____ Division _____ Headquarters _____ Date _____

7100-52-(3/68)

CORNER RECORD (PERPETUATION)

MONUMENT: DESCRIBE NEW MONUMENT SET, OR WORK DONE TO PRESERVE EXISTING MONUMENT

SET A 2"x30" IRON PIPE WITH A BRASS-CAP STAMPED:

T6S R30E

S14

4 S23

1978

PLS 346

MONUMENT IS IN A MOUND OF STONES.

9

ACCESSORIES : DESCRIBE NEW BT'S WITNESS OBJECTS ETC. ESTABLISHED, OR WORK DONE TO PRESERVE EXISTING EVIDENCE

16" PINE N34E 15.0' MARKED: 1/4 S14 BT

THE STUMP HAS A BEARING TREE SIGN. THE OTHER BT'S HAVE A RED-PAINTED STRIPE, BEARING TREE SIGNS, AND AN ATTENTION SIGN. THE NEW BT HAS A BRASS WASHER STAMPED PLS 346 NAILED TO THE LOWER BLAZE.

10

Work Done By W.O. HARRIS Title _____ Date _____ State Registration No. PLS 346 or Agency _____

Certified Cor. Record Prepared ? Yes No Filed At: _____ Date _____

11

REMARKS

Index File No. T. R. M. Tract or Surv. No. Cor. 12 13


Index File No. N-19
 T 6S R. 90E
 Merid. _____

CORNER RECORD (SEARCH)
 (Ref. FSM 7151.4)

Tract or Survey No. _____
 Cor. No. N-19

R.D. Ukiah County Umatilla
 N.F. Umatilla State Oregon

CORNER DIAGRAM

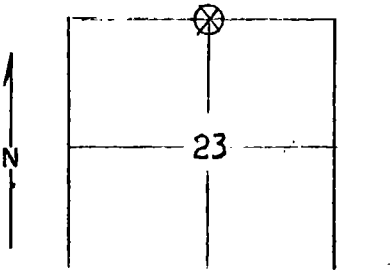

DESCRIBE CORNER MONUMENT FOUND
 A stone 20"x15"x14" all above ground. This is not original corner marker as it was a post.

DESCRIBE BEARING TREES OR OTHER OFFICIAL ACCESSORIES FOUND
 Ponderosa pine 28" DBH bears S19°W 121 lks has been chopped out some time ago, but shows good scribing. Painted 6" red band and scars and attached two signs, stump (pine) bears N15°E 981 lks has a good pitched-over scar with a visible 1/4 S on it. Put two steel posts up near corners location with two signs attached to each one.

PHOTO IDENTIFICATION DATA
 Photo No. _____
 Filed At. _____
 Object Ident. _____
 Ident. By _____
Signature

DESCRIBE CORNER LOCATION RELATIVE TO NEAR-BY FEATURES, ALSO HOW TO REACH CORNER

PLANE COORDINATE POSITION DATA
 State _____ Zone _____
 X _____
 Y _____
 Estab. By _____
Agency

Signature MLC Title For Tech, Division USFS Headquarters Ukiah Date 4/20/78 7100-52 (3,68)