

U. S. Department of Agriculture
FOREST SERVICE

NATIONAL FOREST

CORNERS OF THE PUBLIC SURVEY

T. 68 R. 30E Mer.

Sec 20 Corner common to Sections
16, 17, 20, and 21

Corner consists of a rock mound in place
State condition good

Dimensions above ground _____ inches.

Sketch grooves, letters, figures, or notches, on proper face or edge.

CARDINAL POSITION

DIAGONAL POSITION

No notches			
N	W	S	E
	NW	SW	SE
			NE

Mound of _____ is located _____

Pits are located _____

Sketch markings of Bearing Trees (or Rocks) in proper box
and fill blanks below, giving bearings from Corner to Trees
and Distances in Links.

No	BTS		

Species _____

Diameter _____

Bearing _____

Distance _____


Do you believe this to be a genuine Land Office Corner? ...

If not, why? _____

Aspland
(Signature)
4/16/52
(Date) Lovati
(Title)

T. _____ R. _____ Mer.

(Make sketch of topography near Corner and show section line markers thus "X")

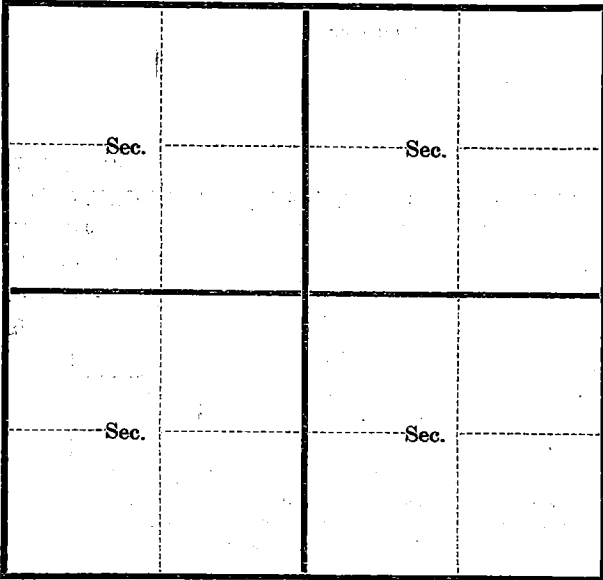

Metal Location Poster is on a _____
 tree _____ inches diameter, on the _____
 side of _____ from which
 this Corner bears _____ Chains.
 (Bearing) (Distance)

Section line marker between Secs. _____ and _____ is on
 a _____ on the _____
 (Tree, post, etc.) (Name of road, trail, etc.)

located _____ chains E, W, N, S, from Sec. Cor.; 1/4 Cor.; Witness Cor.
 (Cross out nonapplicable)

Give any further facts needed to find Corner again:

USDA-FOREST SERVICE

Index File No. N-9


CORNER RECORD (SEARCH)
(Ref. FSM 7151.4)

Tract or Survey No. _____ Cor. No. _____

T 65 R. 30E R.D. _____ County _____

Merid. Will N.F. _____ State OREGON

CORNER DIAGRAM

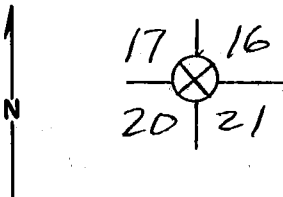

DESCRIBE CORNER MONUMENT FOUND

STONE MOUND IN GOOD CONDITION - No MARKS VISIBLE.

DESCRIBE BEARING TREES OR OTHER OFFICIAL ACCESSORIES FOUND

NONE

PHOTO IDENTIFICATION DATA

Photo No. _____
Filed At. _____
Object Ident. _____
Ident. By _____
Signature

PLANE COORDINATE POSITION DATA

State _____ Zone _____
X _____
Y _____
Estab. By _____
Agency

Signature
A.G. OARD

Title Division
Forester

Headquarters Date
4/16/52

FS-7100-52 (3/68)

CORNER RECORD (PERPETUATION)

MONUMENT: DESCRIBE NEW MONUMENT SET, OR WORK DONE TO PRESERVE EXISTING MONUMENT

ACCESSORIES : DESCRIBE NEW BT'S WITNESS OBJECTS ETC. ESTABLISHED, OR WORK DONE TO PRESERVE EXISTING EVIDENCE

9

10

Work Done By _____ Title _____ Date _____ State Registration No. _____
or Agency _____

Certified Cor. Record Prepared ? Yes No Filed At _____ Date _____

11

REMARKS

Index File No. T. R. M. Tract or Surv. No. Cor.

12

13